


DATE	DATE	DATE
06-01-02	05-05-05	05-05-05
05-01-02	05-05-05	05-05-05

THE EXISTENCE OF RIGHTS OF WAY AND OR EASEMENTS OF RECORD IF ANY, NOT SHOWN ARE NOT GUARANTEED.

DIST: 900 SECTION: 360 BLOCK: 3 TAX LOT: 85

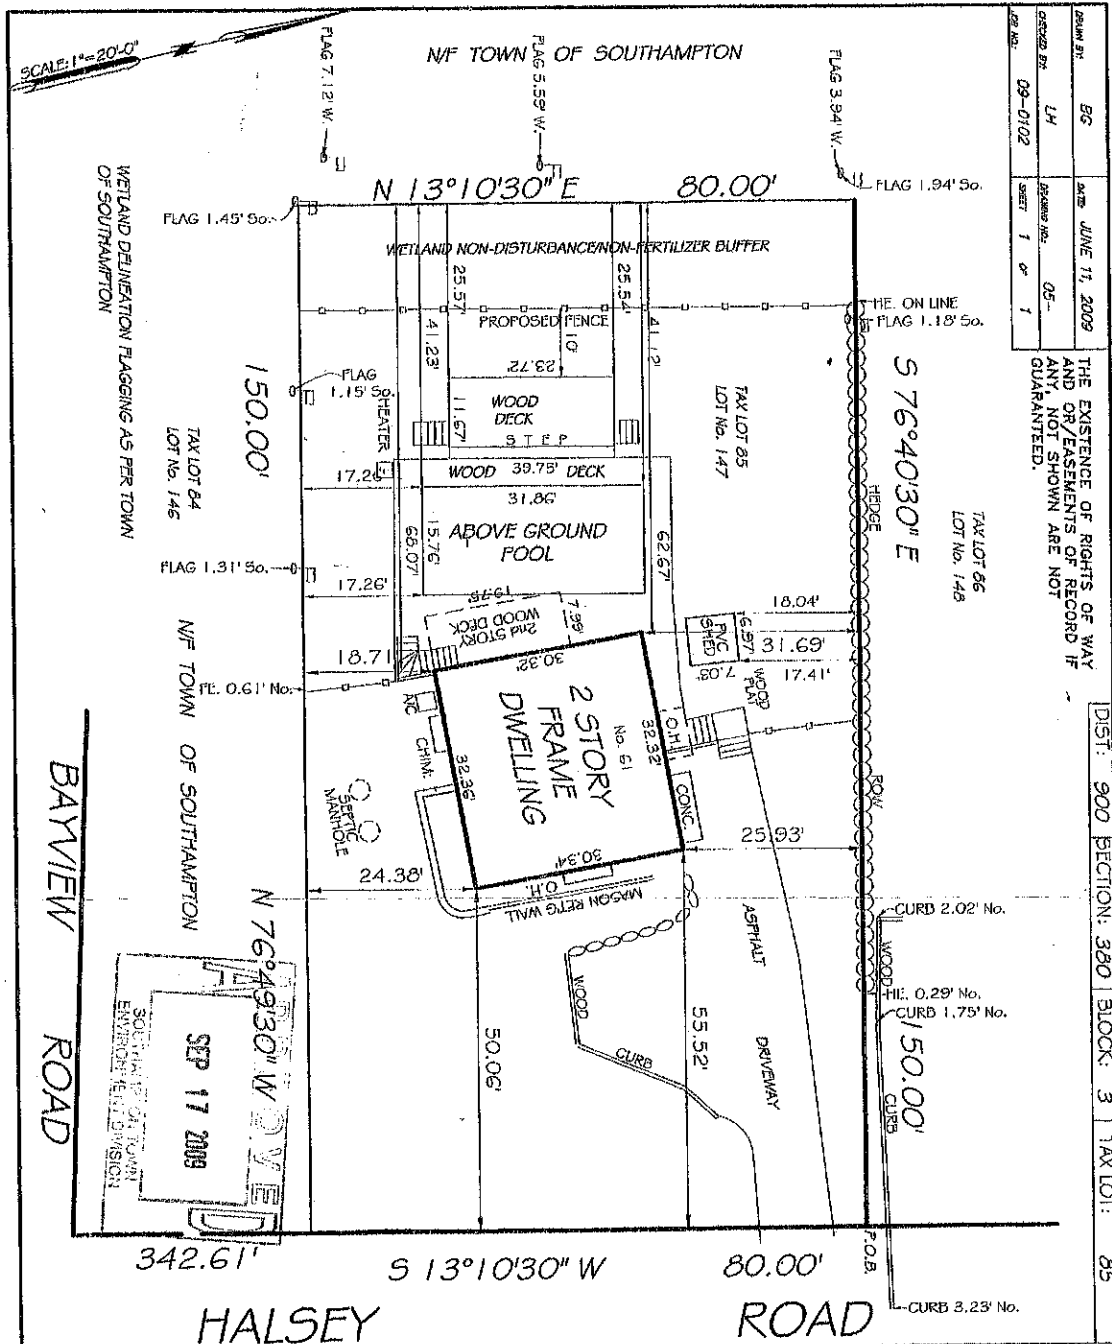

MAP OF PROPERTY
SITUE AT
REMSENBERG
TOWN OF SOUTHAMPTON
SUFFOLK COUNTY, N. Y.

LOT NUMBERS:
LOT No. 147 MAP OF SPECK SHORE
FILED: OCTOBER 5, 1916 AS MAP No. 200

UNAUTHORIZED ALTERATION OR ADDITION TO THIS SURVEY IS A VIOLATION OF SECTION 7205 OF THE NEW YORK STATE EDUCATION LAW.

COPIES OF THIS SURVEY MAP NOT BEARING THE SURVEYOR'S SEAL OR EMBOSSED SEAL SHALL NOT BE CONSIDERED TO BE A VALID TRUE COPY.

GUARANTEES INDICATED HEREON SHALL RUN ONLY TO THE PERSON FOR WHOM THE SURVEY IS PREPARED AND FOR WHOM THE SURVEY IS FORWARDED TO THE SURVEYOR AND TO THE ASSIGNEES OF THE LENDING INSTITUTION. GUARANTEES ARE NOT TRANSFERABLE.

SURVEYED: JUNE 11, 2009
UPDATED: SEPTEMBER 11, 2009

MINTO PRECISION SURVEYING
2 BELL COURT
LAKE RONKONKOMA, N.Y. 11756
TEL: 831-580-4844
FAX: 831-580-1202

LAURENCE MICHAEL HAYNES
LICENSED LAND SURVEYOR
189 LAFAYETTE DRIVE
STYOSSET, N.Y. 11791
TEL: 1-866-308-5800