


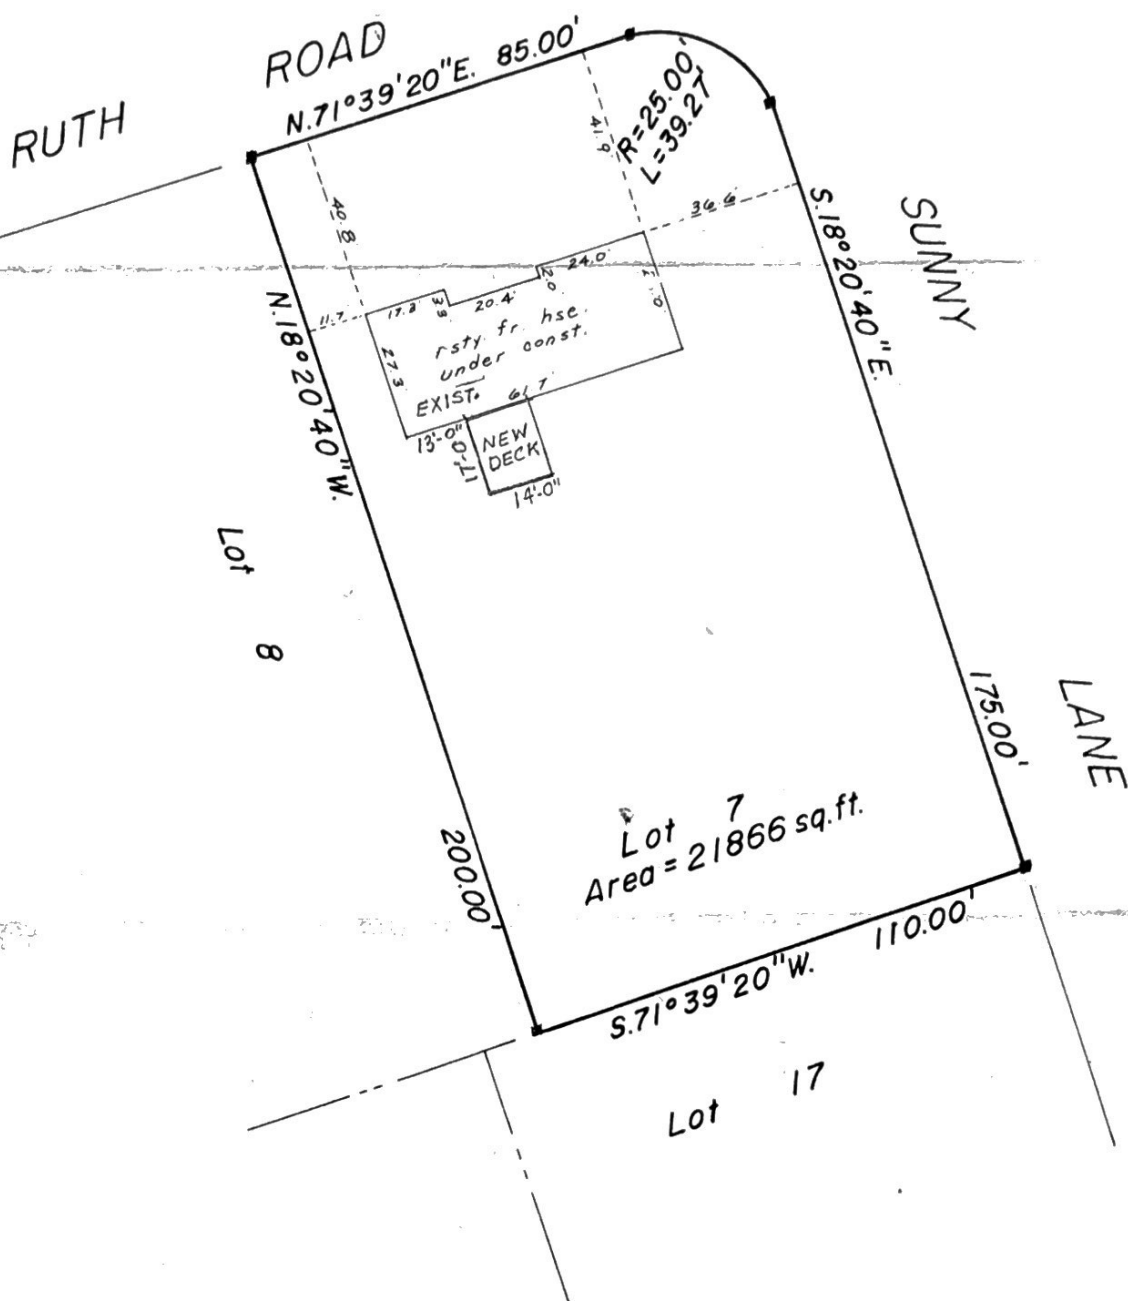

NOTE:
 ■ = MONUMENT
 SUBDIVISION MAP FILED IN THE OFFICE
 OF THE CLERK OF SUFFOLK COUNTY ON
 APRIL 9, 1970 AS MAP NO. 5448.

REVISED OCT. 6, 1971	YOUNG & YOUNG 400 OSTRANDER AVENUE, RIVERHEAD, N.Y. ALDEN W. YOUNG PROFESSIONAL ENGINEER AND LAND SURVEYOR, N.Y.S. LIC. NO. 12845			HOWARD W. YOUNG LAND SURVEYOR N.Y.S. LIC. NO. 45893	
	SURVEY FOR ROMAN BAJLAK & ANNA BAJLAK LOT 7 "SUNSET KNOLLS" SECTION TWO				
	AT MATTITUCK			GUARANTEED TO: SECURITY TITLE & GUARANTY CO. SOUTHOLD SAVINGS BANK	
	TOWN OF SOUTHOLD				
	SUFF. CO., N.Y.			BY <i>Alden W. Young</i>	
	SCALE: 1" = 40'		DATE NOV. 2, 1970		NO. 70-369