


Receipt # 0602082

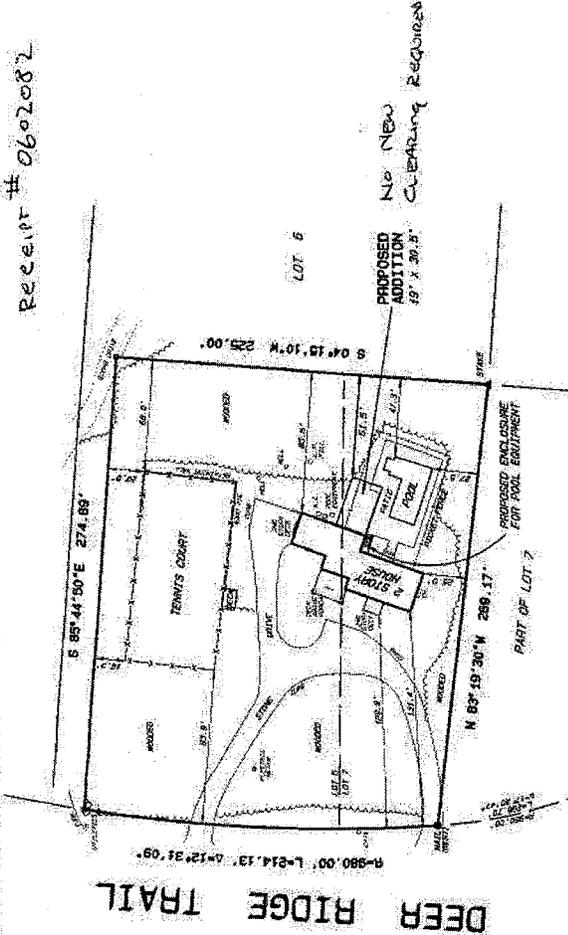

SITE PLAN
OF

LOT 5 & PART OF LOT 7
DEER RIDGE
RETAIN & IMPROVE

FILE NO. 7011 FILED: SEPTEMBER 15, 1981
SITUATE


NORTH OF WATER MILL
TOWN OF SOUTHAMPTON
SUFFOLK COUNTY, N.Y.

SCALE: 1" = 60'

AREA = 60,448 S.F.

TAX MAP NO.: 0950-084.00-02.00-060.033

Site Plan - 210.151PF. 031301.511 19-Jun-06 02:57 PM / 313-1

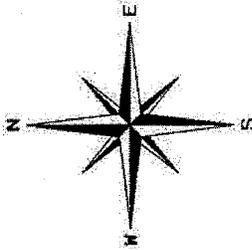


UNAUTHORIZED ALTERATION OR ADDITION TO A SURVEY AND
BEARING A LICENSED LAND SURVEYOR'S SEAL IS A VIOLATION
OF THE PROFESSIONAL ETHICS SUBSECTION 2. OF THE NEW YORK STATE
SEAL ACT.

ONLY COPIES FROM THE ORIGINAL OF THIS MAP BURNED
ON A PRESERVED PAPER SHALL BE CONSIDERED TO BE VALID FOR
LEGAL PURPOSES. ANY OTHER COPIES SHALL BE CONSIDERED
INVALID. ANY CHANGES TO THIS MAP MUST BE MADE BY THE
ORIGINAL SURVEYOR OR HIS AUTHORIZED REPRESENTATIVE.
PROPOSED IMPROVEMENTS SHOWN ON THIS MAP ARE BASED
ON THE INFORMATION PROVIDED TO THE SURVEYOR AND THE
DESIGN AND/OR SITE PLAN. THE SURVEYOR'S PROFESSIONAL
RESPONSIBILITY IS ASSIGNED TO THE SURVEYOR FOR CHECKING
THE ACCURACY OF THE INFORMATION PROVIDED BY THE CLIENT.
REGULATIONS.

EXISTING CONDITIONS DERIVED FROM AERIAL PHOTOGRAPHS
AND FIELD SURVEY. THIS MAP WAS FILED ON
DECEMBER 28, 2005.

PREPARED: DECEMBER 23, 2005
REVISED: JUNE 19, 2006

1,000 SQ. FT.

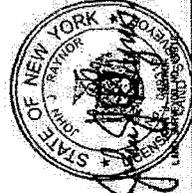

JOHN J. RAYNOR, P.E. & L.S., P.C.	
SURVEYORS	CIVIL ENGINEERS
DEERFIELD GREEN	WATER MILL, N.Y. 11976
P.O. BOX 740	(845) 789-7800
SITE PLANNERS	

Note & Comments

Previous