


DRAWN BY	JM	CHECKED BY	JM
CAD FILE DATE:	August 2024		
DRAWING NO.:	24\Cox Lane		

Premises known as:
1555 Cox Lane

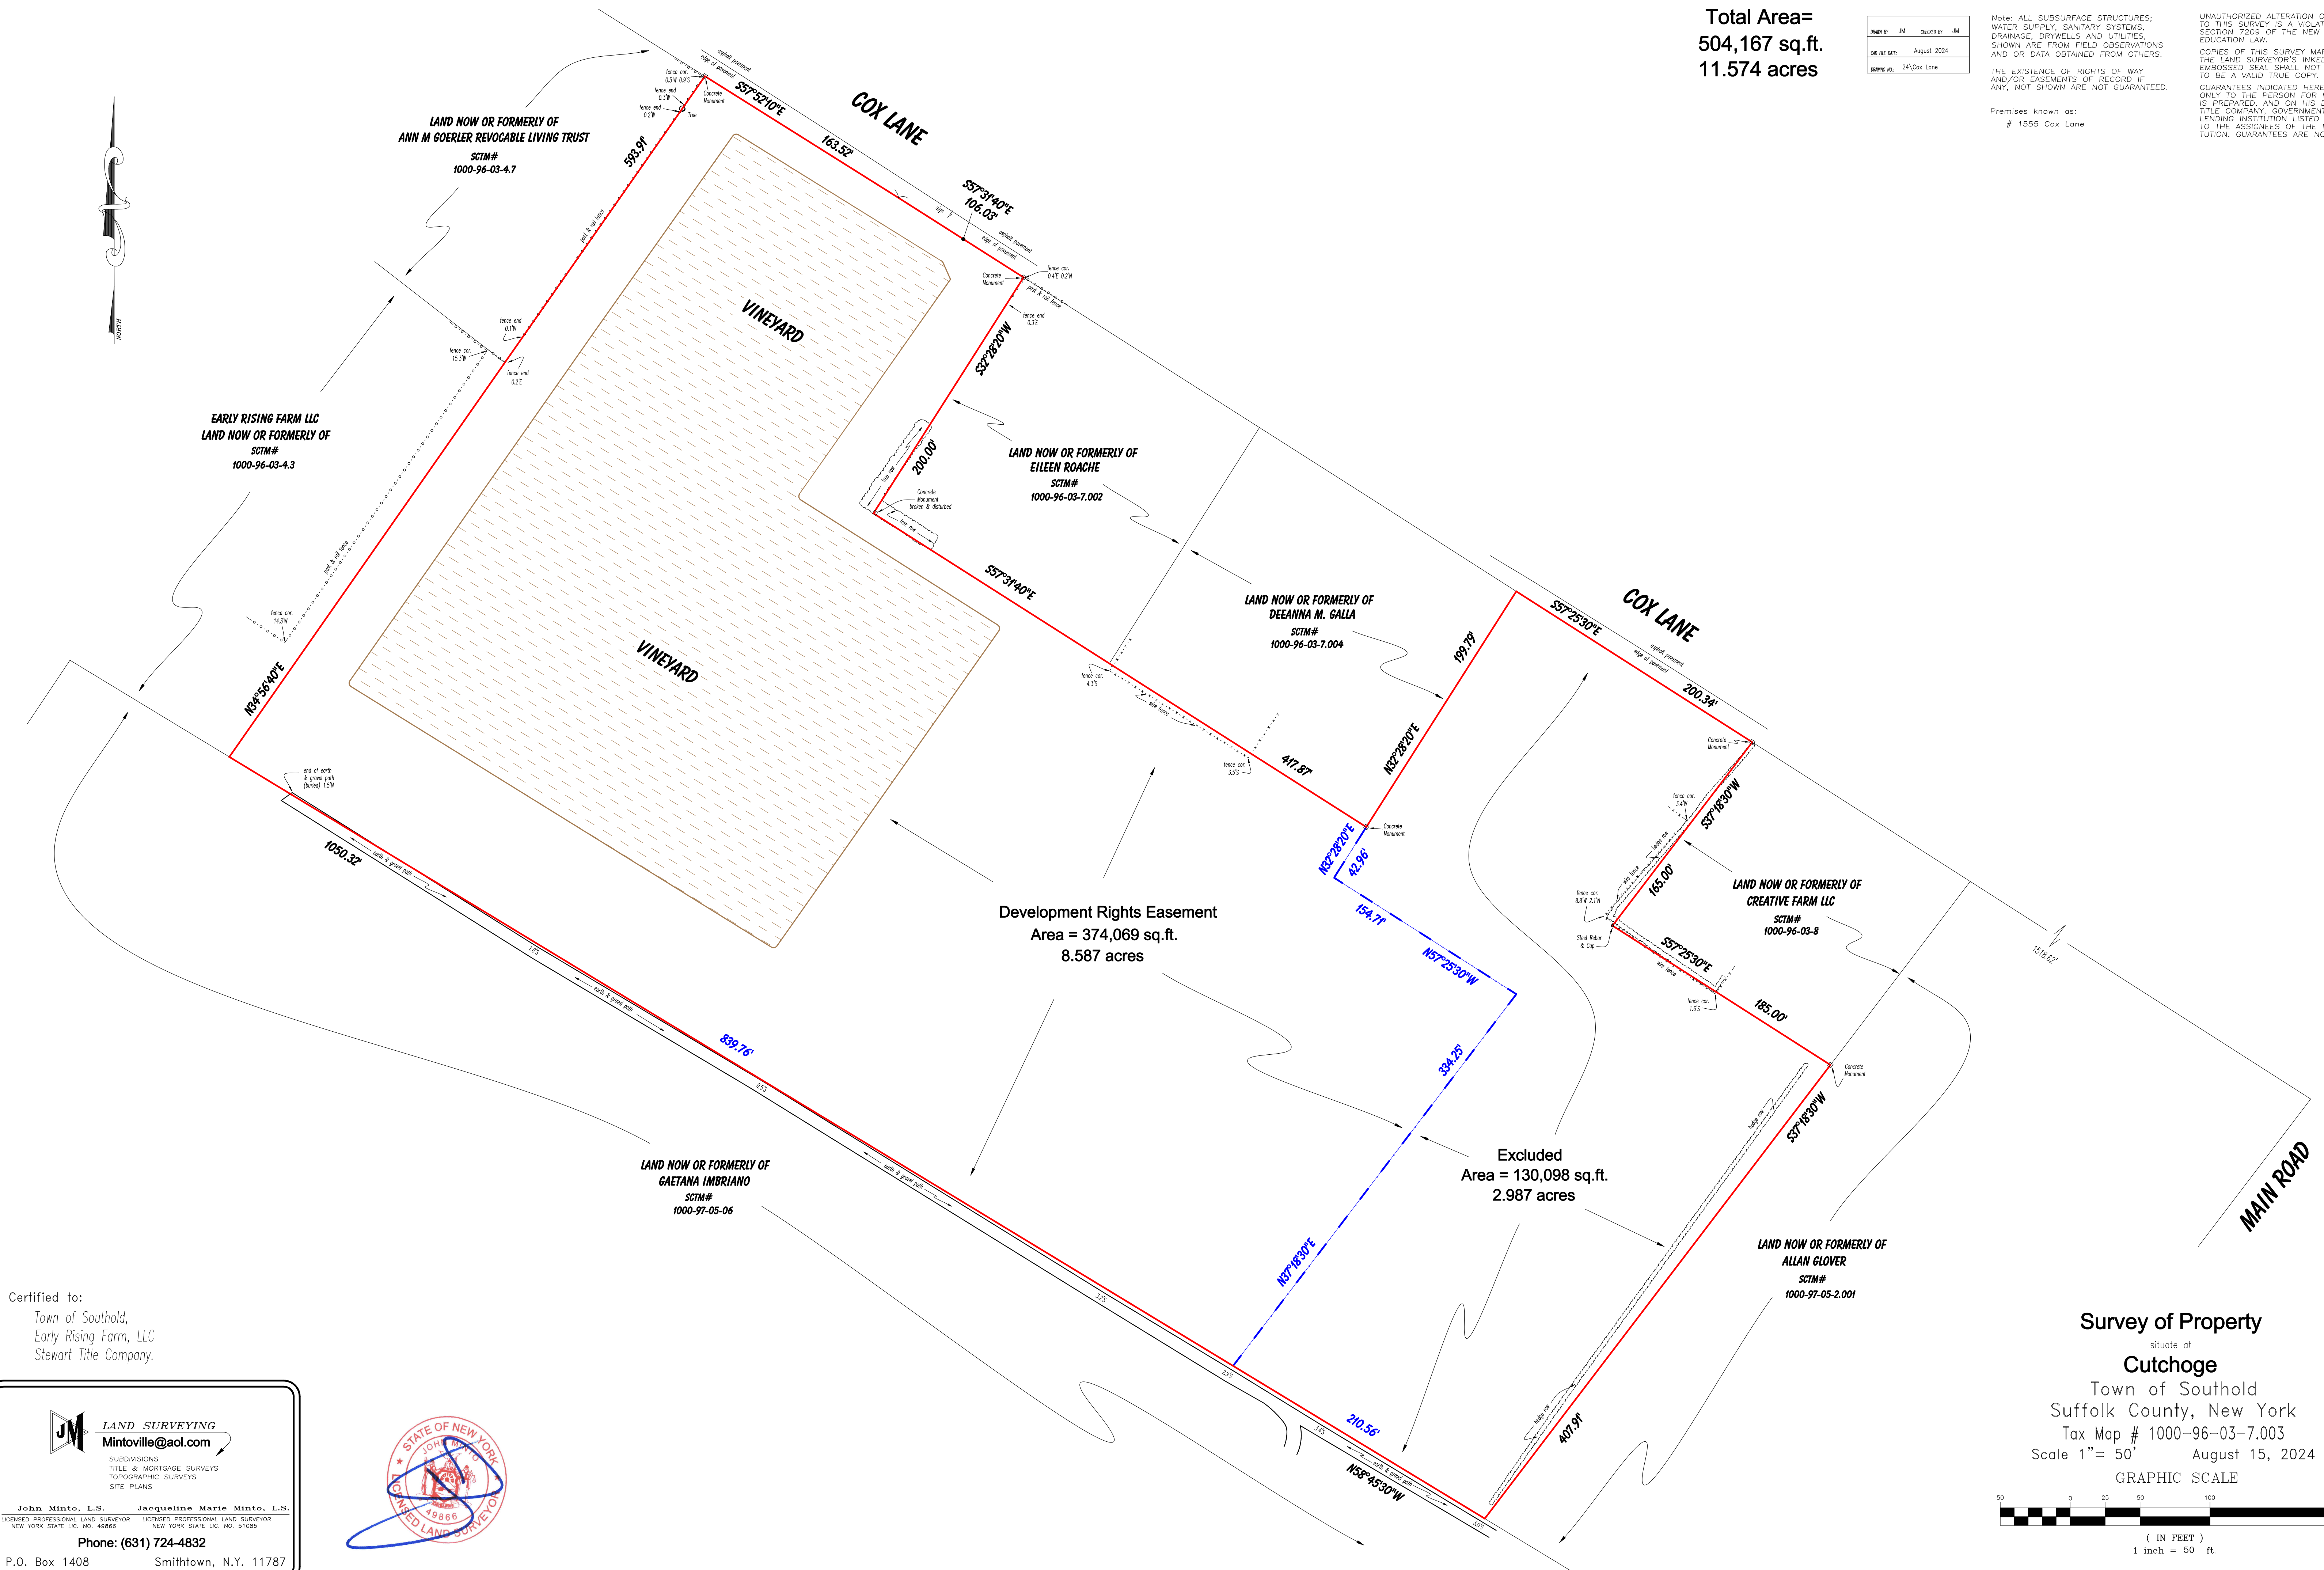

JM
LAND SURVEYING
Mintoville@aol.com
 SUBDIVISIONS
 TITLE & MORTGAGE SURVEYS
 TOPOGRAPHIC SURVEYS
 SITE PLANS

John Minto, L.S.	Jacqueline Marie Minto, L.S.
LICENSED PROFESSIONAL LAND SURVEYOR NEW YORK STATE LIC. NO. 49866	LICENSED PROFESSIONAL LAND SURVEYOR NEW YORK STATE LIC. NO. 51085
Phone: (631) 724-4832	
P.O. Box 1408	Smithtown, N.Y. 11787



(IN FEET)
1 inch = 50 ft.