
15-1-3

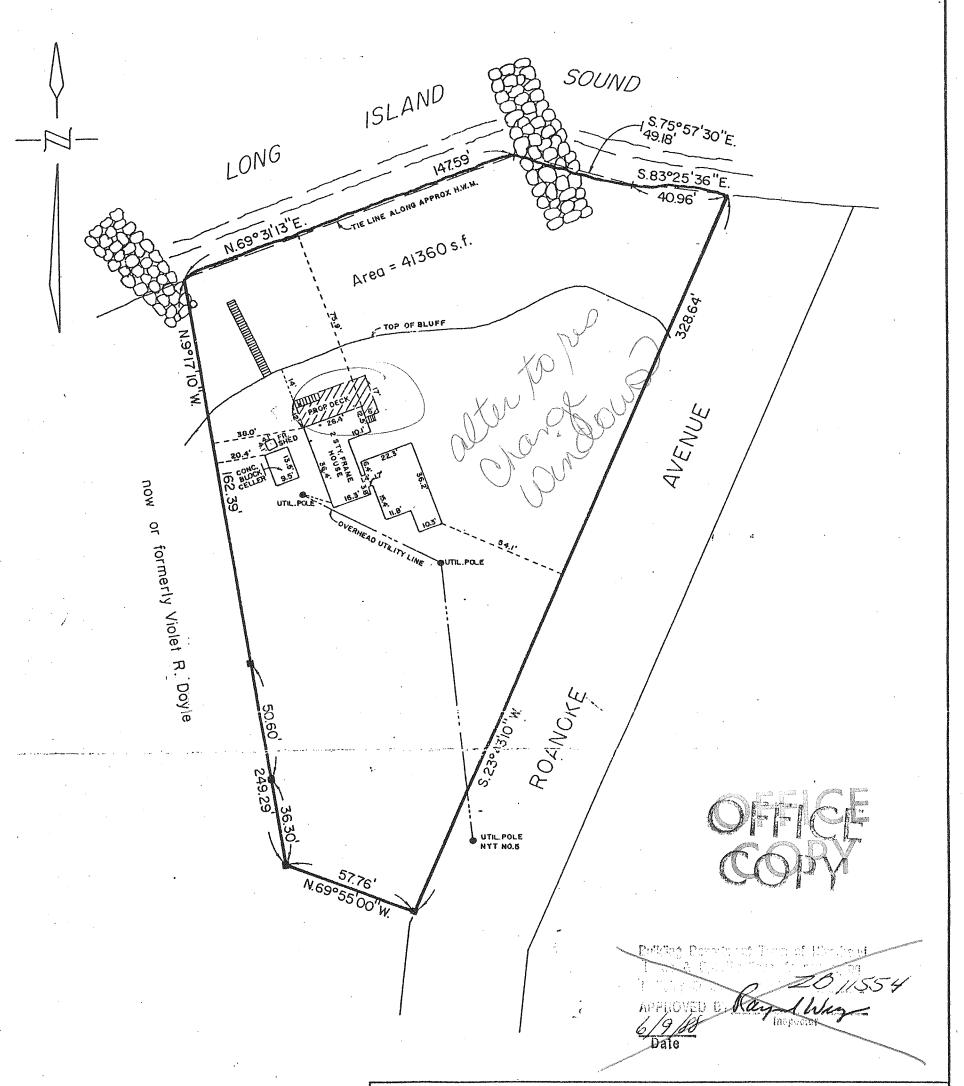

NOTES:

Service Servic

I. M = MONUMENT

2. SUFFOLK CO. TAX MAP DIST. 600 SECT. 15 BL . I LOT 3

Service in the service of the servic

Building Department Town of Riverhead Plans & Specifications Accompanying Building-Zoning Permit No.4

APPROVED BY Keepword Willy Sale

Inspector

SURVEY FOR

NANCY RINEHART

AT ROANOKE

TOWN OF RIVERHEAD

SUFFOLK COUNTY, NEW YORK

UNAUTHORIZED ALTERATION OR ADDITION TO THIS SURVEY IS A VIOLATION OF SECTION 7209 OF THE NEW YORK STATE EDUCATION LAW.
COPIES OF THIS SURVEY NOT BEARING THE LAND SURVEYOR'S INKED SEAL OR EMBOSSED SEAL SHALL NOT BE CONSIDERED TO BE A VALID TRUE COPY.
GUARANTEES INDICATED HEREON SHALL RUN ONLY TO THE PERSON FOR WHOM THE SURVEY IS PREPARED, AND ON HIS BEHALF TO THE TITLE COMPANY, GOVERNMENTAL AGENCY AND LENDING INSTITUTION LISTED HEREON, AND TO THE ASSIGNEES OF THE LENDING INSTITUTION. GUARANTEES ARE NOT TRANSFERABLE TO ADDITIONAL INSTITUTIONS OR SUBSEQUENT OWNERS. OWNERS.

OWNERS.

H DISTANCES SHOWN HEREON FROM PROPERTY LINES TO EXISTING STRUCTURES ARE FOR A SPECIFIC PURPOSE AND ARE NOT TO BE USED TO ESTABLISH PROPERTY LINES OR FOR THE ERECTION OF FENCES.





YOUNG & YOUNG

ALDEN W. YOUNG, PROFESSIONAL ENGINEER

AND LAND SURVEYOR NY.S. LICENSE NO.12845 HOWARD W. YOUNG, LAND SURVEYOR N.Y.S. LICENSE NO. 45893

400 OSTRANDER AVENUE RIVERHEAD, NEW YORK

DATE : NOV. 5,1987 SCALE: 1"= 40"

: 87-1434