


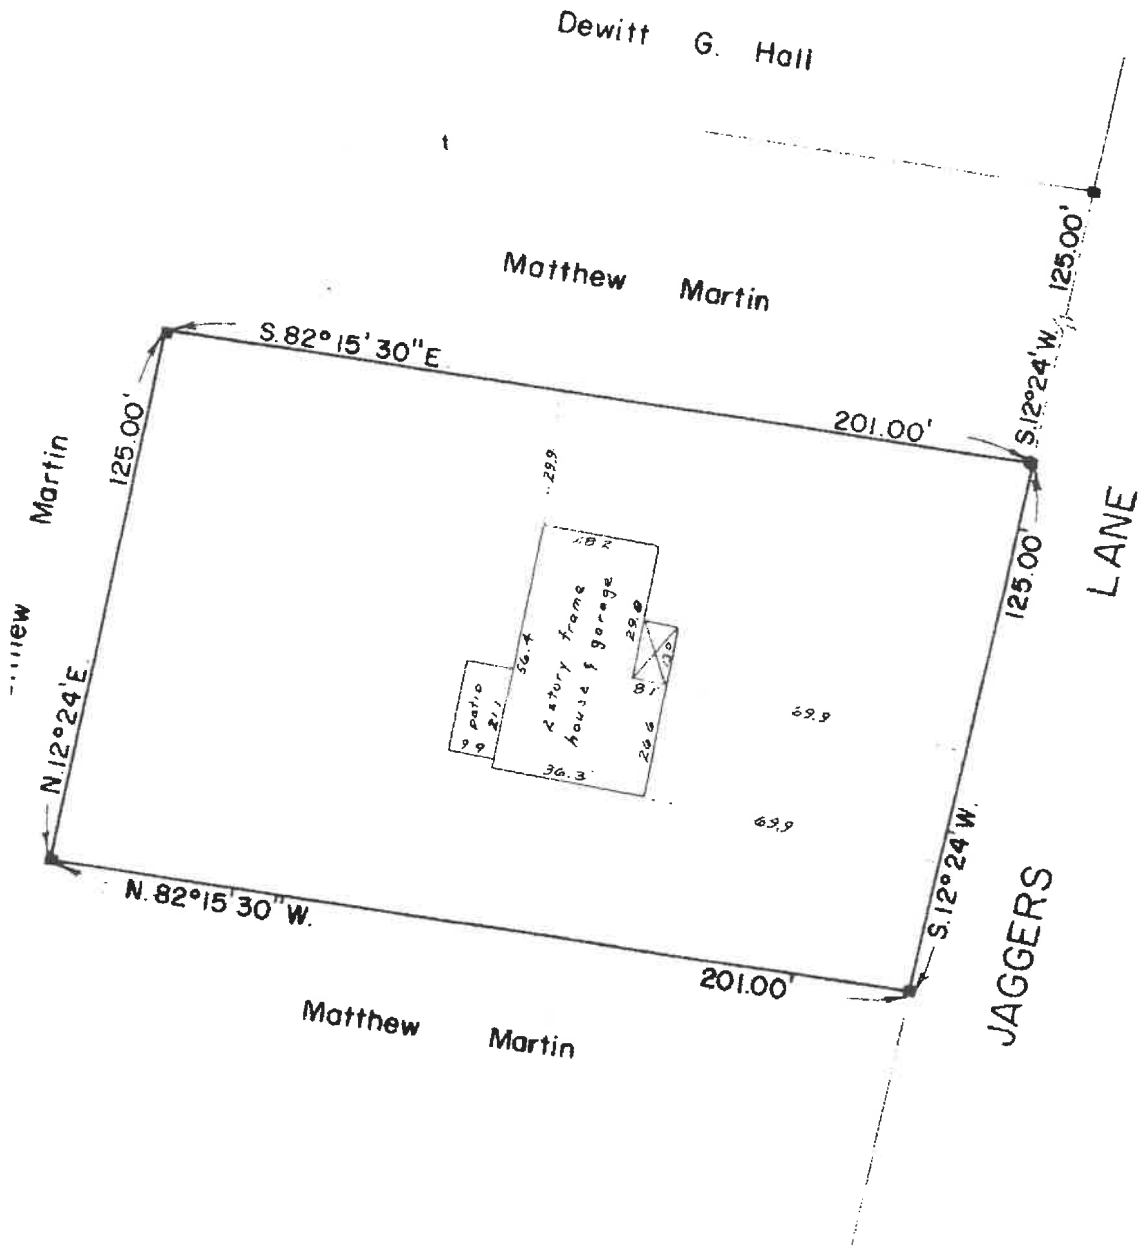

NOTE:
■ = MONUMENT

SURVEY FOR
CHESTER NOWAK & ANN NOWAK
WESTHAMPTON
TOWN OF SOUTHAMPTON
SUFF. CO., N.Y.

SCALE: 1" = 40'

NOV. 6, 1970

JAN. 27, 1971

JUNE 11, 1971

GUARANTEED TO:
RIVERHEAD SAVINGS BANK
THE TITLE GUARANTEE CO
YOUNG & YOUNG
BY

Alden M. Young
PROFESSIONAL ENGINEER
LAND SURVEYOR, N.Y.S. LIC. N
RIVERHEAD, N.Y.