

LA = 42,209 sq.ft.


LOT NO. 233

LOT NO. 234

LOT NO. 235

LOT NUMBER 209

LOT NUMBER 211

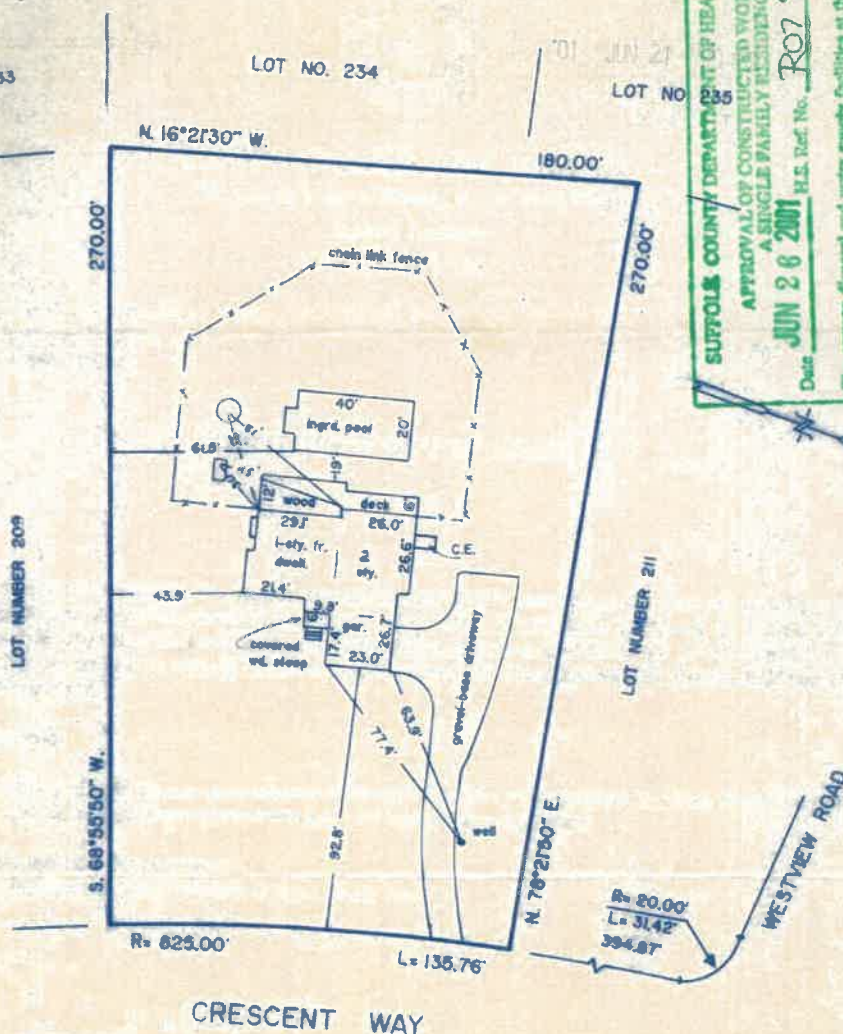

CESSPOOL, SEPTIC TANK and
WELL LOCATIONS BY OTHERS

LOT NUMBER 196

LOT NUMBER 197

NOTE: LOCATION OF ADJOINERS WELLS
AND CESSPOOLS BY OTHERS
AND ARE NOT GUARANTEED.

LOCATE BLDG. and FINAL SURVEY 6-5-2001

WE OFFER (OR IMAGINE) HOWN HEREON FROM THE TRUCKER TO THE PROPERTY HAS USE FOR A SPECIFIC PURPOSE AND USE AND THEREFORE ARE NOT INTENDED TO GUIDE THE SECTION OF PENCES, PLANNING VARIOUS, POOL, PAGES, PLANNING VARIOUS, PLANNING TO BUILDINGS IN ANY OTHER CONSTRUCTION.

UNAUTHORIZED ALTERATION OR ADDITION TO THIS SURVEY IS A VIOLATION OF SECTION 7209 OF THE NEW YORK STATE EDUCATION LAW.

GUARANTEES INDICATED HEREON SHALL RUN ONLY TO THE PERSON FOR WHOM THE SURVEY IS PREPARED, AND ON HIS BEHALF TO THE TITLE COMPANY, GOVERNMENTAL AGENCY AND LENDING INSTITUTION LISTED HEREON, AND TO THE ASSIGNEES OF THE LENDING INSTITUTION. GUARANTEES ARE NOT TRANSFERABLE TO ADDITIONAL INSTITUTIONS OR SUBSEQUENT OWNERS.

COPIES OF THIS SURVEY MAP NOT BEARING THE LAND SURVEYOR'S EXED SEAL OR EMOVED SEAL SHALL NOT BE CONSIDERED TO BE A VALID COPY.

GUARANTEED ONLY TO

JOB NO. 00 - 405

FILE NO. HAY BEACH POINT

SURVEYED FOR

LOT NUMBER 210

MAP OF HAY BEACH POINT SECTION 7

SITUATED AT SHELTER ISLAND

TOWN OF SHELTER ISLAND-SUFFOLK COUNTY N.Y.

SCALE 1" = 50'

DATE 8-21-2000

FILED MAP NO. 5443

DATE 3-31-1976

TAX MAP NO. 700-01-01-76

(REF. ONLY) DISK222

HAROLD F. TRANCHON JR. P.C.
LAND SURVEYOR

1866 WADING RIVER-MANOR RD. WADING RIVER,
NEW YORK, 11792
631-929-4695

HAROLD F. TRANCHON JR.

N.Y. LIC. NO. 048992
PENN. LIC. NO. 21115-E

SUFFOLK COUNTY DEPARTMENT OF HEALTH SERVICES
APPROVAL OF CONSTRUCTED WORKS FOR
A SINGLE FAMILY RESIDENCE

Date JUN 26 2001 H.E. Ref. No. R07 99 0061

The sewage disposal and water supply facilities at this location have been inspected and/or certified by this Department or other agencies and found to be satisfactory FOR A MAXIMUM OF 4 YEARS.

Stephen A. Costa, P.E., Chief

Office of Water and Wastewater Management