


C-7217-2566

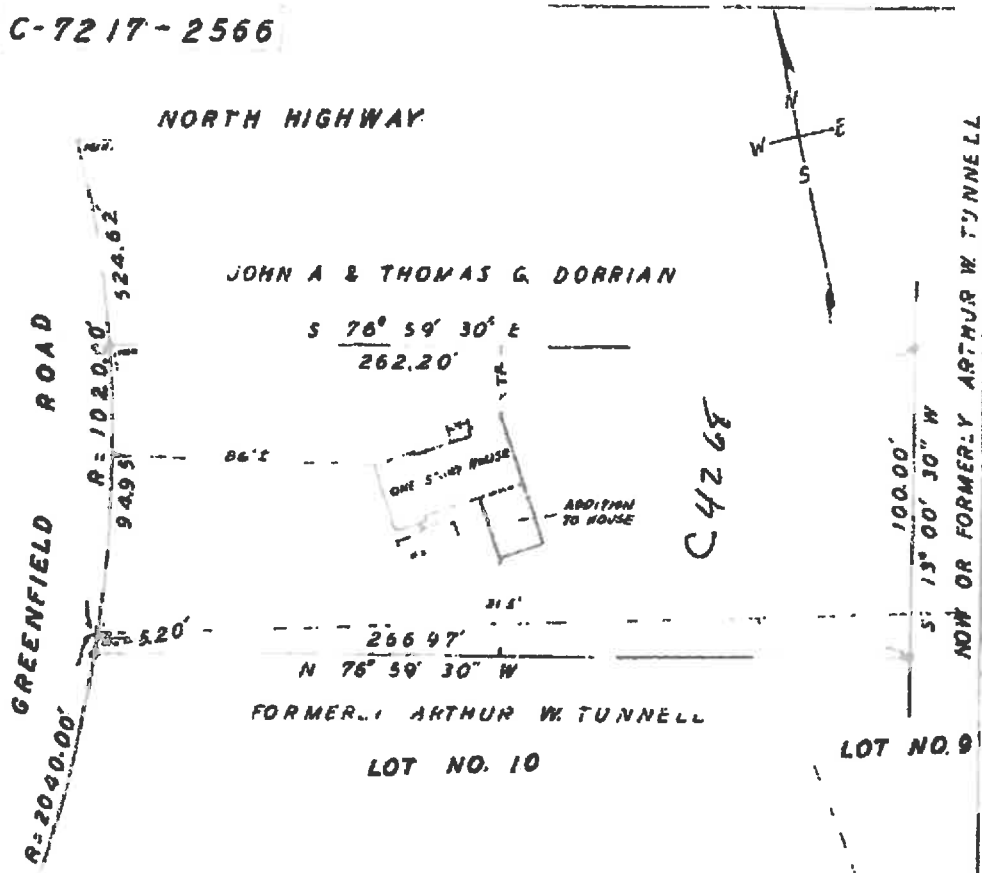

MAP OF PART OF LOTS
 NO. 9 & 10
 BLOCK 92
 OWNED BY
JOSEPH A. DANZ JR.
 AND ELLEN DANZ
 SITUATE
 SHINNECOCK HILLS
 TOWN OF SOUTHAMPTON
 N. Y.

SURVEYED JUNE 22, 1955; REVISED JULY 26, 1955 (FDN.)
 GUARANTEED TO:
 INTER COUNTY TITLE GUARANTY & MORTGAGE CO.
 SUFFOLK COUNTY FEDERAL SAVINGS & LOAN ASSN
 THEODORE F. SQUIRES

Frederick J. Aguirre
 LICENSED LAND SURVEYOR NO. 15683
 SOUTHAMPTON, N.Y.

SCALE: $\frac{1''}{40'}$
 $\frac{1''}{35'}$
 $\frac{1''}{42'}$