

SURVEY OF PROPERTY

Situate
NORTHWEST
Town Of East Hampton
Suffolk County, New York


SCALE: 1" = 30'

AREA: 20.263 sq. ft.
or 0.4652 acres

ZONING DISTRICT: "A5" (WRO)

Certified only to:

Michael J. Wlechowski

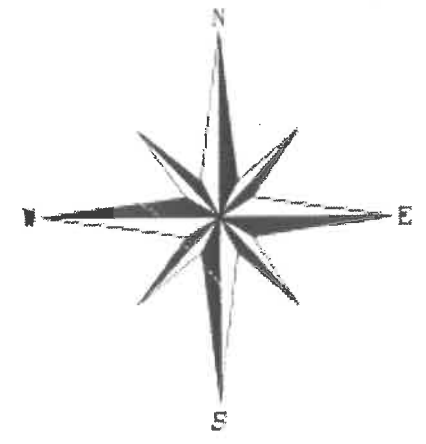


CLEARING CALCULATIONS
Area of lot = 20.263 sq. ft.
Area allowed to clear = 10.000 sq. ft.
Cleared area as measured 6/12/2008 = 8.614 sq. ft.
Proposed Limits of Clearing = 9.958 sq. ft.

- indicates found concrete monument.
- indicates found "Bronxstone" monument.
- indicates set 12" iron pin.
- △ indicates set stake.

NOTES:

- Unauthorized alteration or addition to a survey map bearing a licensed land surveyor's seal is a violation of section 2202 sub-division 2 of the N.Y. State Education Law.
- Only copies from the original of this survey, worked with an original of the land surveyor's embossed seal or inked seal shall be considered to be valid copies.
- Certifications indicated hereon signify that this survey was prepared in accordance with the existing Code of Practice for Land Surveys adopted by the N.Y. State Association of Professional Land Surveyors. Said certifications shall run only to the person for whom the survey is prepared, and on his behalf to the title company, governmental agency and lending institution listed hereon, and to the assignees of the lending institution. Certifications are not transferable to additional institutions or subsequent owners.
- Underground improvements or encroachments, if any, are not shown hereon.
- The existence of right of ways, wetlands and/or easements of record, if any,

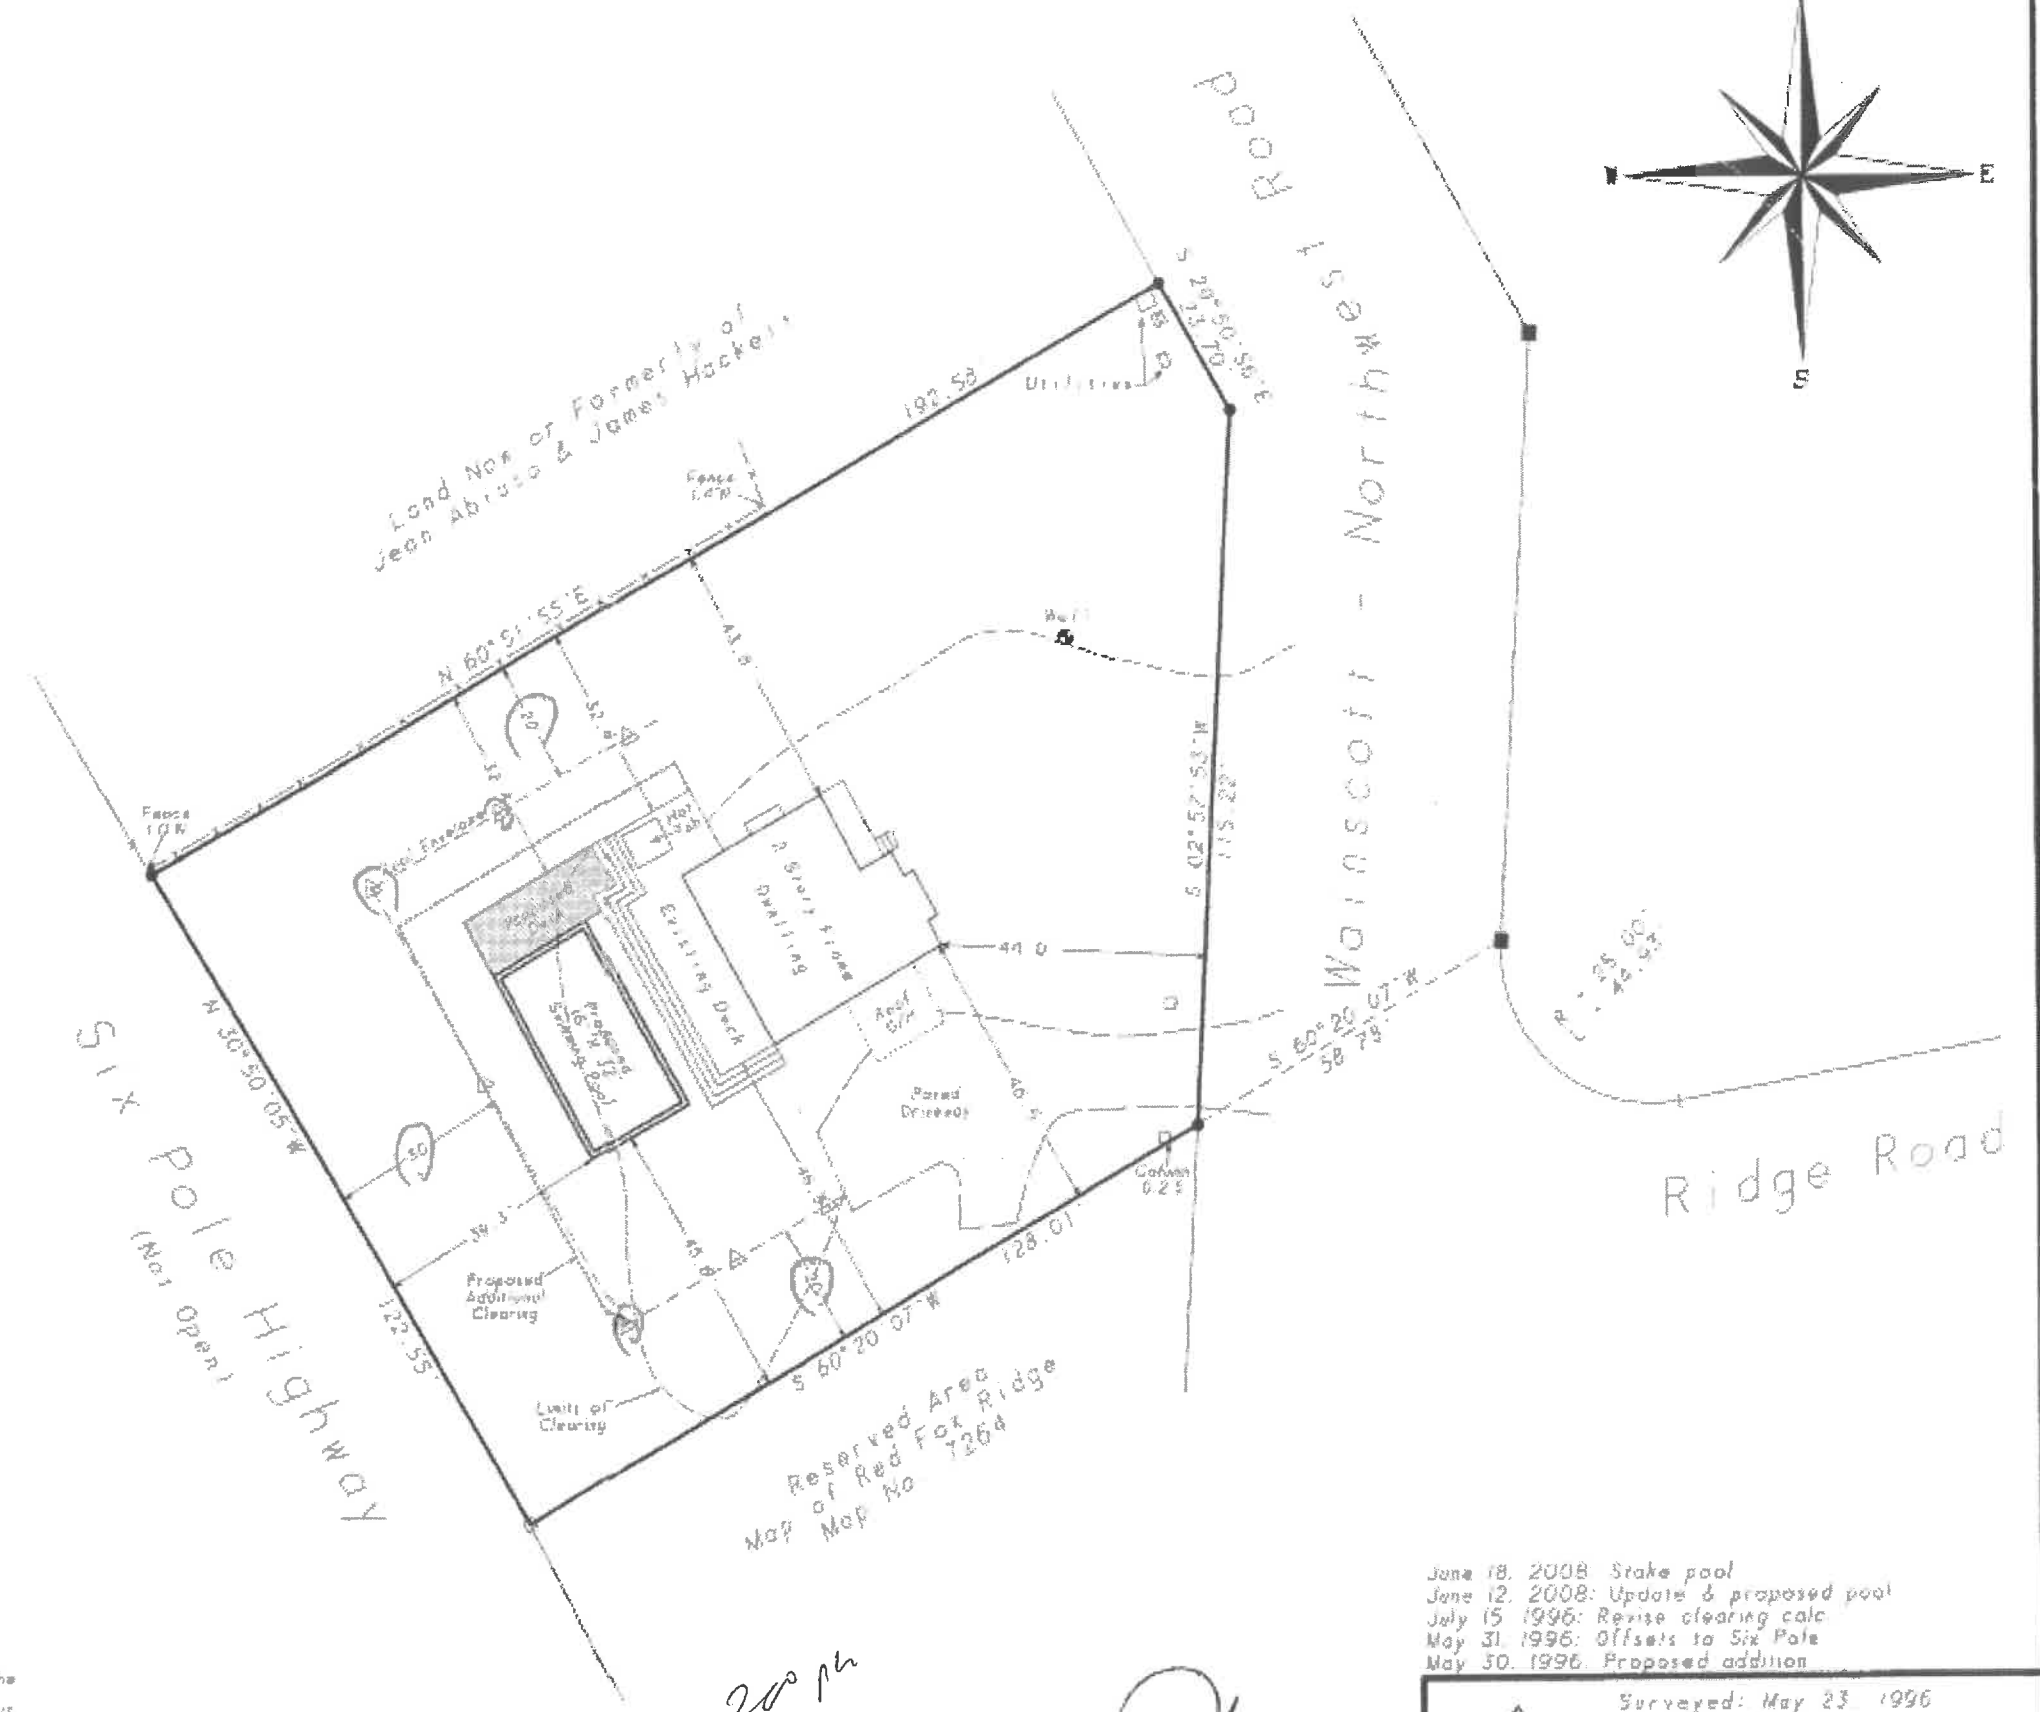


to 10,000 or 35% in

200 ft

OK

June 18, 2008 Stake pool
June 12, 2008: Update & proposed pool
July 15, 1996: Revise clearing calc
May 31, 1996: Offsets to Six Pole
May 30, 1996: Proposed addition

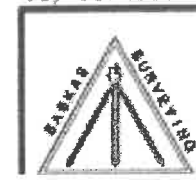

Surveyed: May 23, 1996
David L. Sashas
N.Y.S. Lic. No. 049960
Sashas Surveying Company, P.C.
124 Cedar Street
East Hampton, New York 11937