


4970 - A6770

LOT #6

NOW OR FORMERLY:
ROBERT DOWNS

N 1° 32' 46" E 174.00'

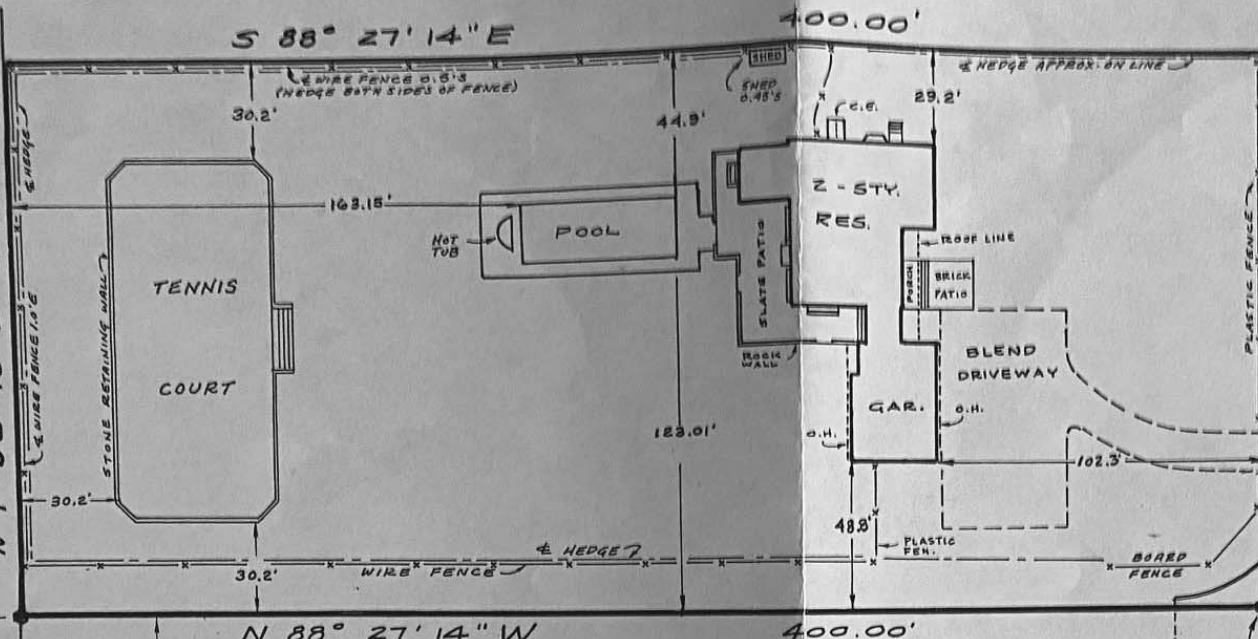

N 88° 27' 14" W

VILLAGE OF SOUTHAMPTON
OPEN SPACE (FORMERLY ROAD)

LOT #4

REVISED: JAN. 6, 2004 (FINAL ON ADDITIONS)
SURVEYED: NOV. 12, 2001

KARL W. WEISENBACHER, L.S. No. 36195
S.H.W. & S. LAND SURVEYORS, P.C.
SQUIRES, HOLDEN,
WEISENBACHER & SMITH

LAND SURVEYORS - ENGINEERS
SOUTHAMPTON, N.Y.

BOOK ~ PAGE

452	58 & 59
736	137 & 138
755	151 & 152
792	123 & 126

WICKAPOGUE RD.

• DENOTES REBAR

SUFFOLK COUNTY TAX MAP

DISTRICT: 0904

SECTION: 020.00

BLOCK: 02.00

PARCEL: 039.001

DOWNS PATH

MAP OF LOT No. 5
AND NORTHERLY 15'
OF ABANDONED
VILLAGE ROAD

SUBDIVISION MAP OF

WICKAPOGUE FARMS

MAP NO. 6970 ~ FILED: APRIL 1, 1981

FOR

DAVID & GAIL BELL

SITUATE

INC. VILLAGE OF
SOUTHAMPTON

TOWN OF SOUTHAMPTON

SUFFOLK COUNTY, N.Y.

SCALE: 1" = 50'

(AREA = 69,600 S₂. FT.)