


S.C.T.M.# DISTRICT: 600 SECTION:9 BLOCK: 1 LOT: 11.4

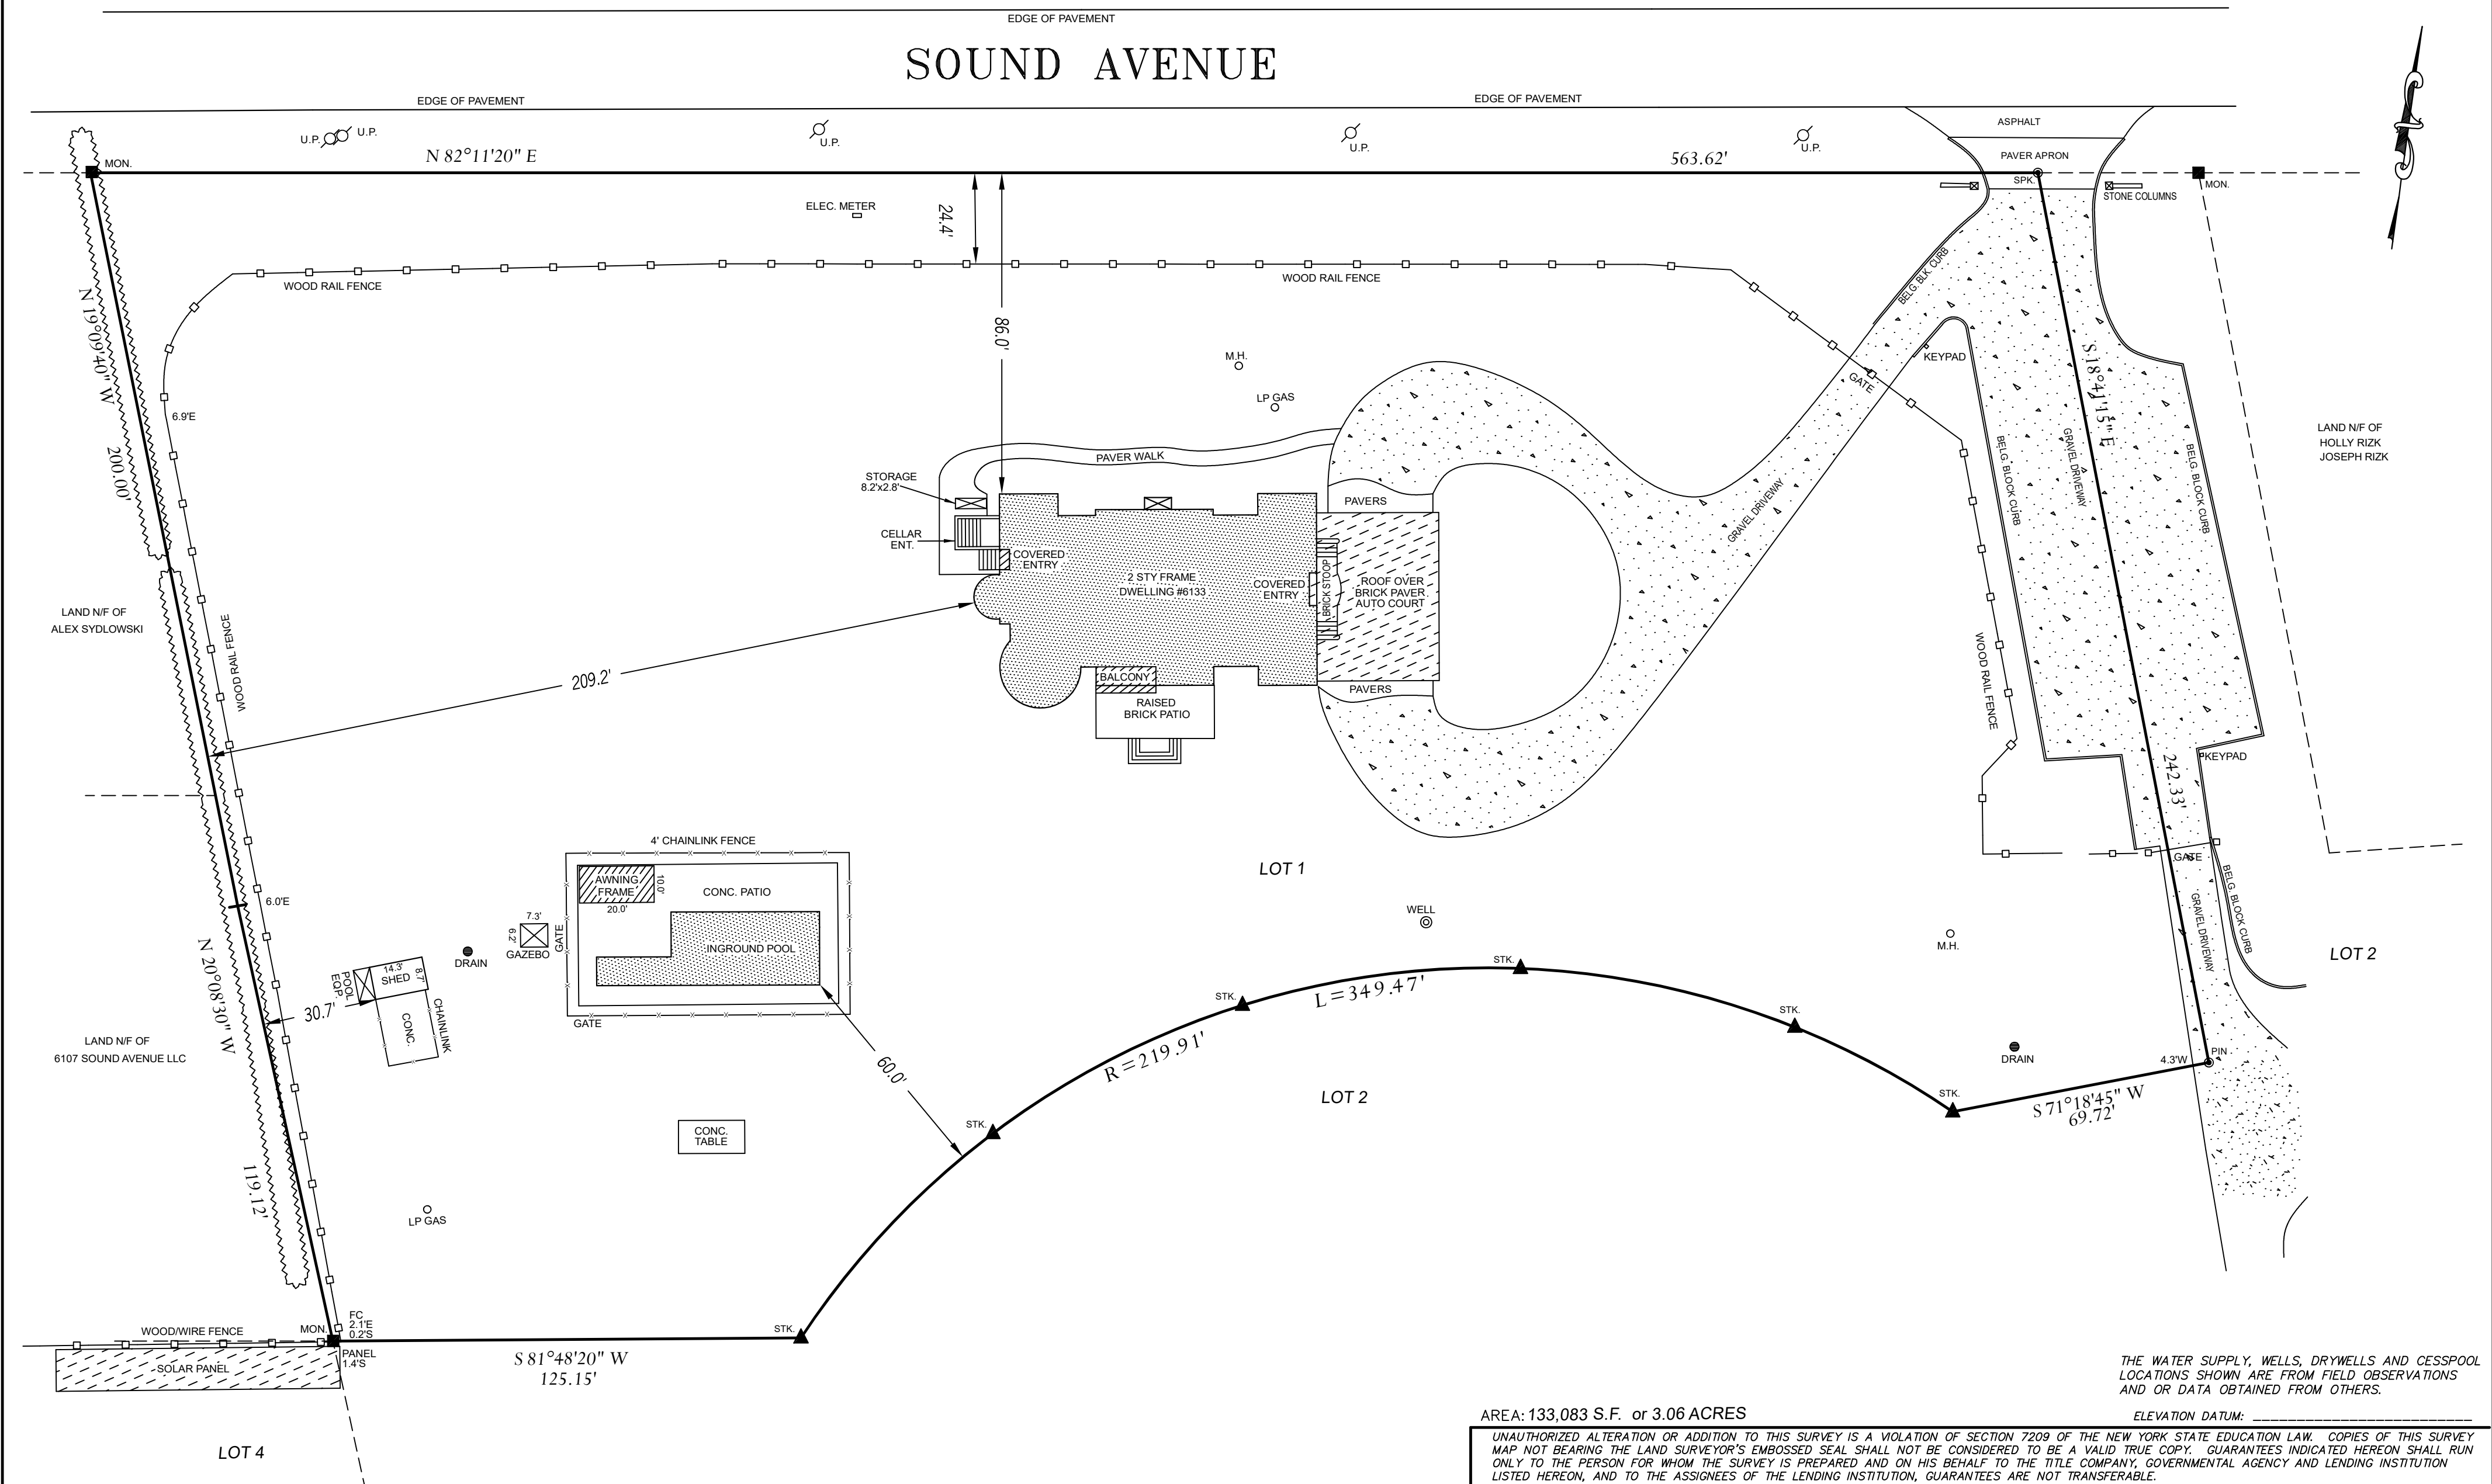

THE WATER SUPPLY, WELLS, DRYWELLS AND CESSPOOL LOCATIONS SHOWN ARE FROM FIELD OBSERVATIONS AND OR DATA OBTAINED FROM OTHERS.


ELEVATION DATUM: _____

AREA: 133,083 S.F. or 3.06 ACRES

UNAUTHORIZED ALTERATION OR ADDITION TO THIS SURVEY IS A VIOLATION OF SECTION 7209 OF THE NEW YORK STATE EDUCATION LAW. COPIES OF THIS SURVEY MAP NOT BEARING THE LAND SURVEYOR'S EMBOSSED SEAL SHALL NOT BE CONSIDERED TO BE A VALID TRUE COPY. GUARANTEES INDICATED HEREON SHALL RUN ONLY TO THE PERSON FOR WHOM THE SURVEY IS PREPARED AND ON HIS BEHALF TO THE TITLE COMPANY, GOVERNMENTAL AGENCY AND LENDING INSTITUTION LISTED HEREON, AND TO THE ASSIGNEES OF THE LENDING INSTITUTION, GUARANTEES ARE NOT TRANSFERABLE.

THE OFFSETS OR DIMENSIONS SHOWN HEREON FROM THE PROPERTY LINES TO THE STRUCTURES ARE FOR A SPECIFIC PURPOSE AND USE. THEREFORE THEY ARE NOT INTENDED TO MONUMENT THE PROPERTY LINES OR TO GUIDE THE ERECTION OF FENCES, ADDITIONAL STRUCTURES OR OTHER IMPROVEMENTS. EASEMENTS AND/OR SUBSURFACE STRUCTURES RECORDED OR UNRECORDED ARE NOT GUARANTEED UNLESS PHYSICALLY EVIDENT ON THE PREMISES AT THE TIME OF SURVEY.

SURVEY OF: **LOT 1**
MAP OF: **ROBERT ENTENMANN**
FILED: **NOV. 09, 2006 No.11461**
SITUATED AT: **JAMESPORT**
TOWN OF: **RIVERHEAD**
SUFFOLK COUNTY, NEW YORK

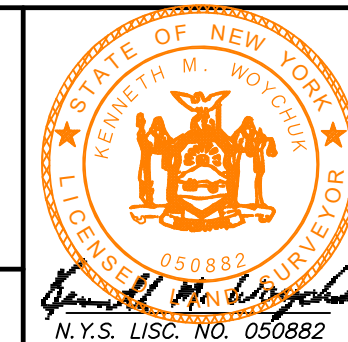

CERTIFIED TO: 133,083 S.F. or 3.06 ACRES

KENNETH M WOYCHUK LAND SURVEYING, PLLC
Professional Land Surveying and Design
P.O. Box 153 Aquebogue, New York 11931
PHONE (631)298-1588 FAX (631) 298-1588

FILE # 224-176 SCALE: 1"=30' DATE: JAN. 10, 2025