


VERIFY SEPTIC SYSTEM & WELL LATERAL
LINE LOCATION PRIOR TO CONSTRUCTION

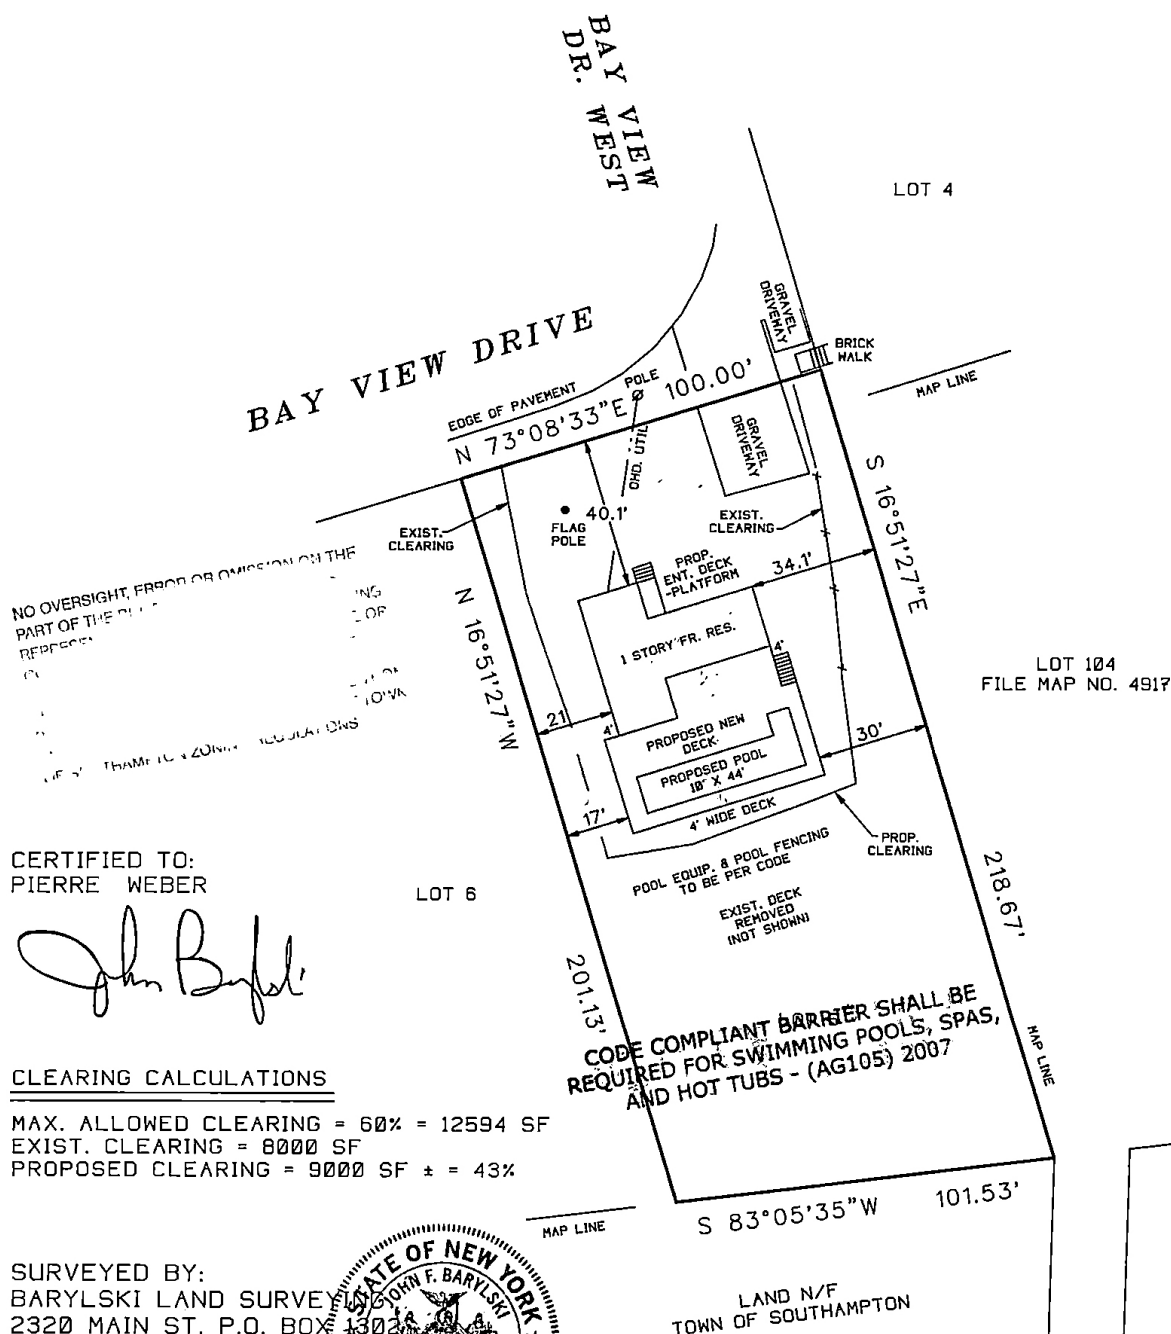

John Bayless

MAX. ALLOWED CLEARING = 60% = 12594 SF
EXIST. CLEARING = 8000 SF
PROPOSED CLEARING = 9000 SF ± = 43%

SURVEYED BY:
BARYLSKI LAND SURVEY
2320 MAIN ST. P.O. BOX 1
NEWMAN VILLAGE COND
BRIDGEHAMPTON, NEW Y
(631-537-7944)
DECEMBER 15, 2006
4-7-2007; REVISE SITE PLAN



20871 (20871-P1)

00:24 PM 4/4/2009 20:24 B4 mod