


Survey of Property



SCT# 1000-144-5-20
Situat: Mattituck
Town: Southold
Suffolk County, NY

SCALE 1" = 30'

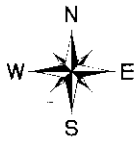

Certified to:
Thomas McDermott

APPROVED BY BOARD OF TRUSTEES TOWN OF SOUTHOLD	
DATE	3/20/13
<i>James F. King</i>	

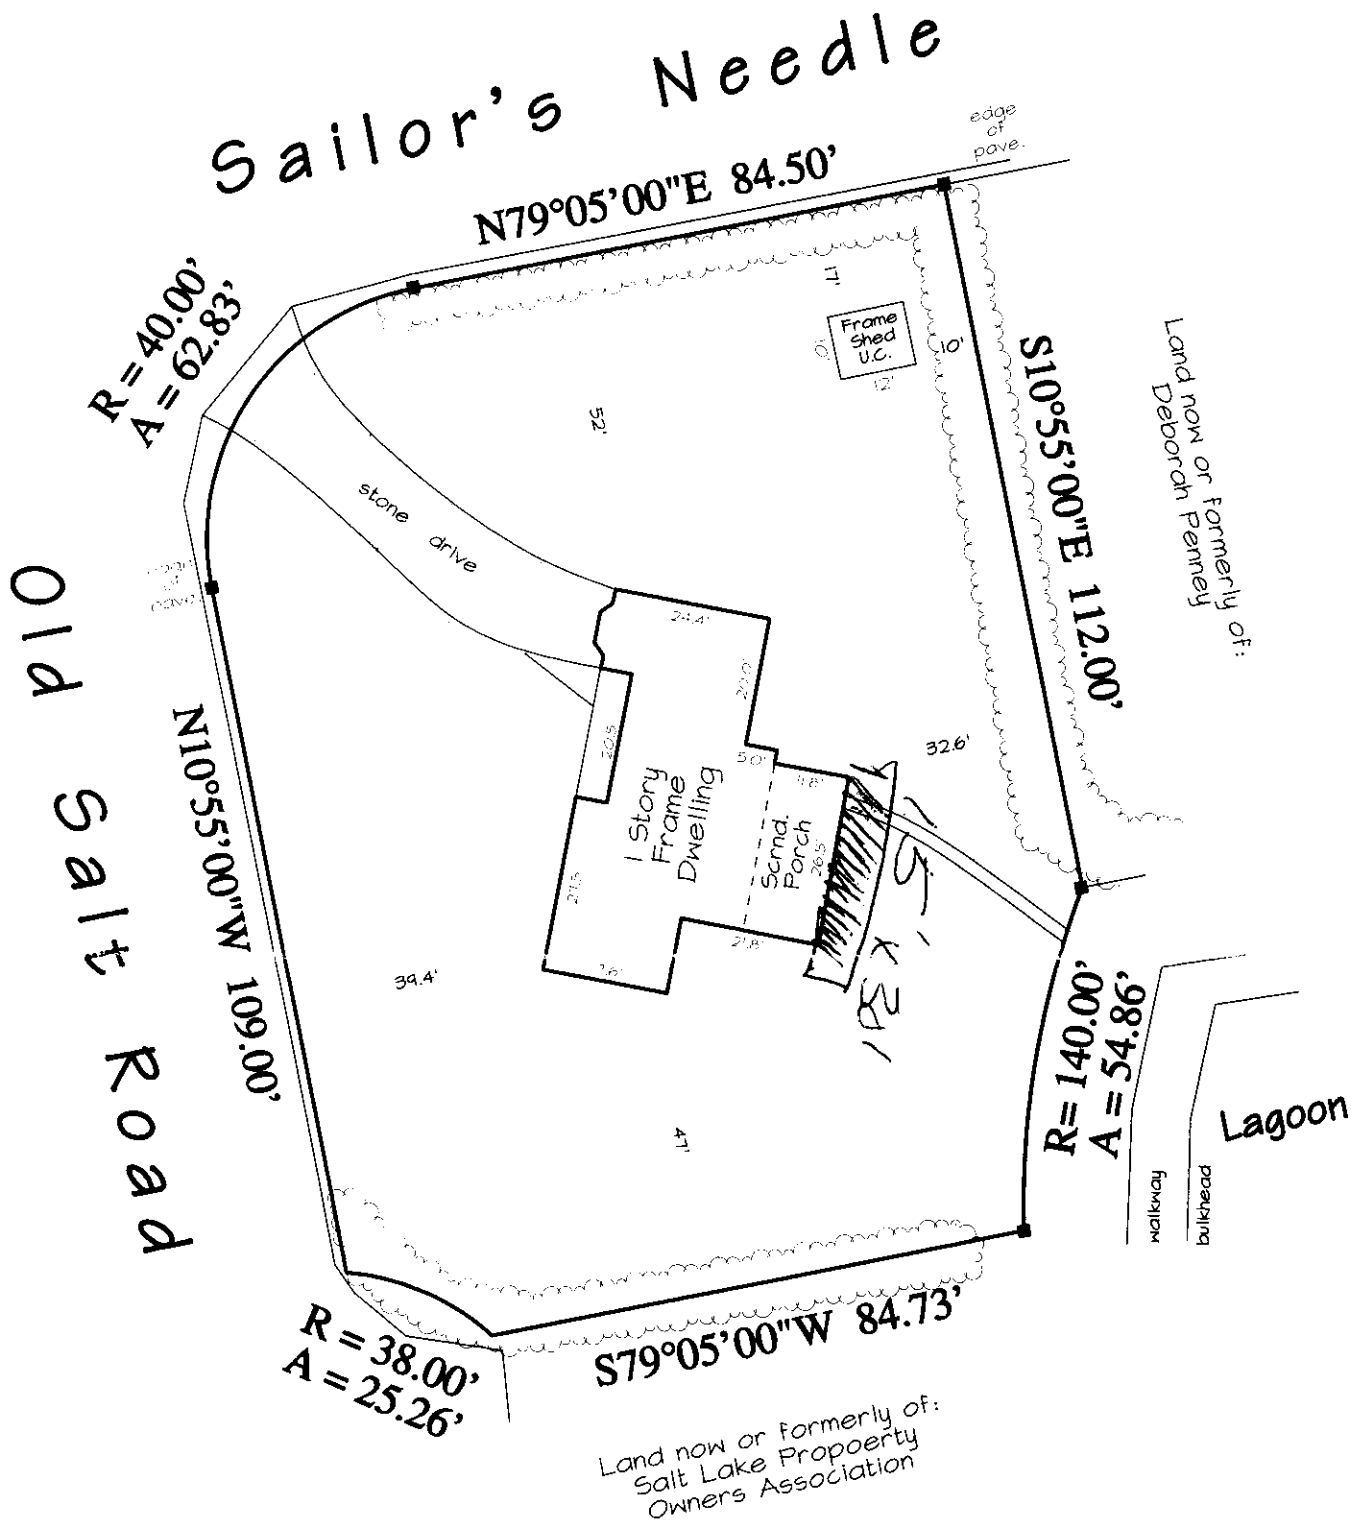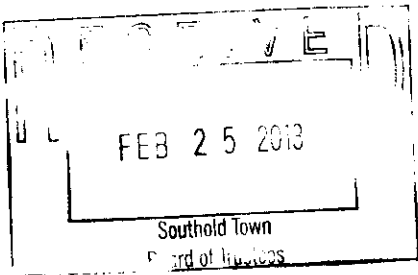

PREPARED BY:
SEA LEVEL
MAPPING
P. O. BOX # 538
RIVERHEAD, NY 11901
PHONE 631-722-3340

THIS PLOT WAS DEVELOPED
FROM SURVEYS OF 06-18-04
ROBERT H. FOX, NYS Lic# 50197
7/6/2004 4:46:45PM C:\Trimble Geomatics Office\Projects\modermt.pro