

CERTIFIED TO:
JANE FRIEDMAN
BANK OF AMERICA, N.A.
FIRST AMERICAN TITLE INSURANCE
COMPANY OF NEW YORK



DAVID H. FOX
LIC. NO. 50234

FOX LAND SURVEYING
PO BOX 224
SPEONK, N.Y. 11972
(516) 325-2902


UNAUTHORIZED ALTERATION OR ADDITION TO THIS SURVEY
IS A VIOLATION OF SECTION 7209 OF THE NEW YORK STATE
EDUCATION LAW. COPIES OF THIS SURVEY MAP NOT BEARING
THE LAND SURVEYOR'S INKED SEAL OR EMBOSSED SEAL
SHALL NOT BE CONSIDERED TO BE A VALID TRUE COPY.

Survey for
JANE FRIEDMAN
Lot 14, "Map of the Grace Estates"
At
Northwest
Town of
East Hampton
Suffolk County, New York

S.C.T.M.: 0300-054.00-03.00-014.000

NOTES:

1. TOTAL AREA = 89,465 S.F.
2. ■ = MONUMENT FOUND, ▲ = STAKE FOUND, ● = NAIL FOUND.
3. SUBDIVISION MAP FILED IN THE OFFICE OF THE CLERK OF SUFFOLK COUNTY ON JAN. 02, 1986 AS FILE NO. 8042.
4. AREA CLEARED = 21183 S.F.

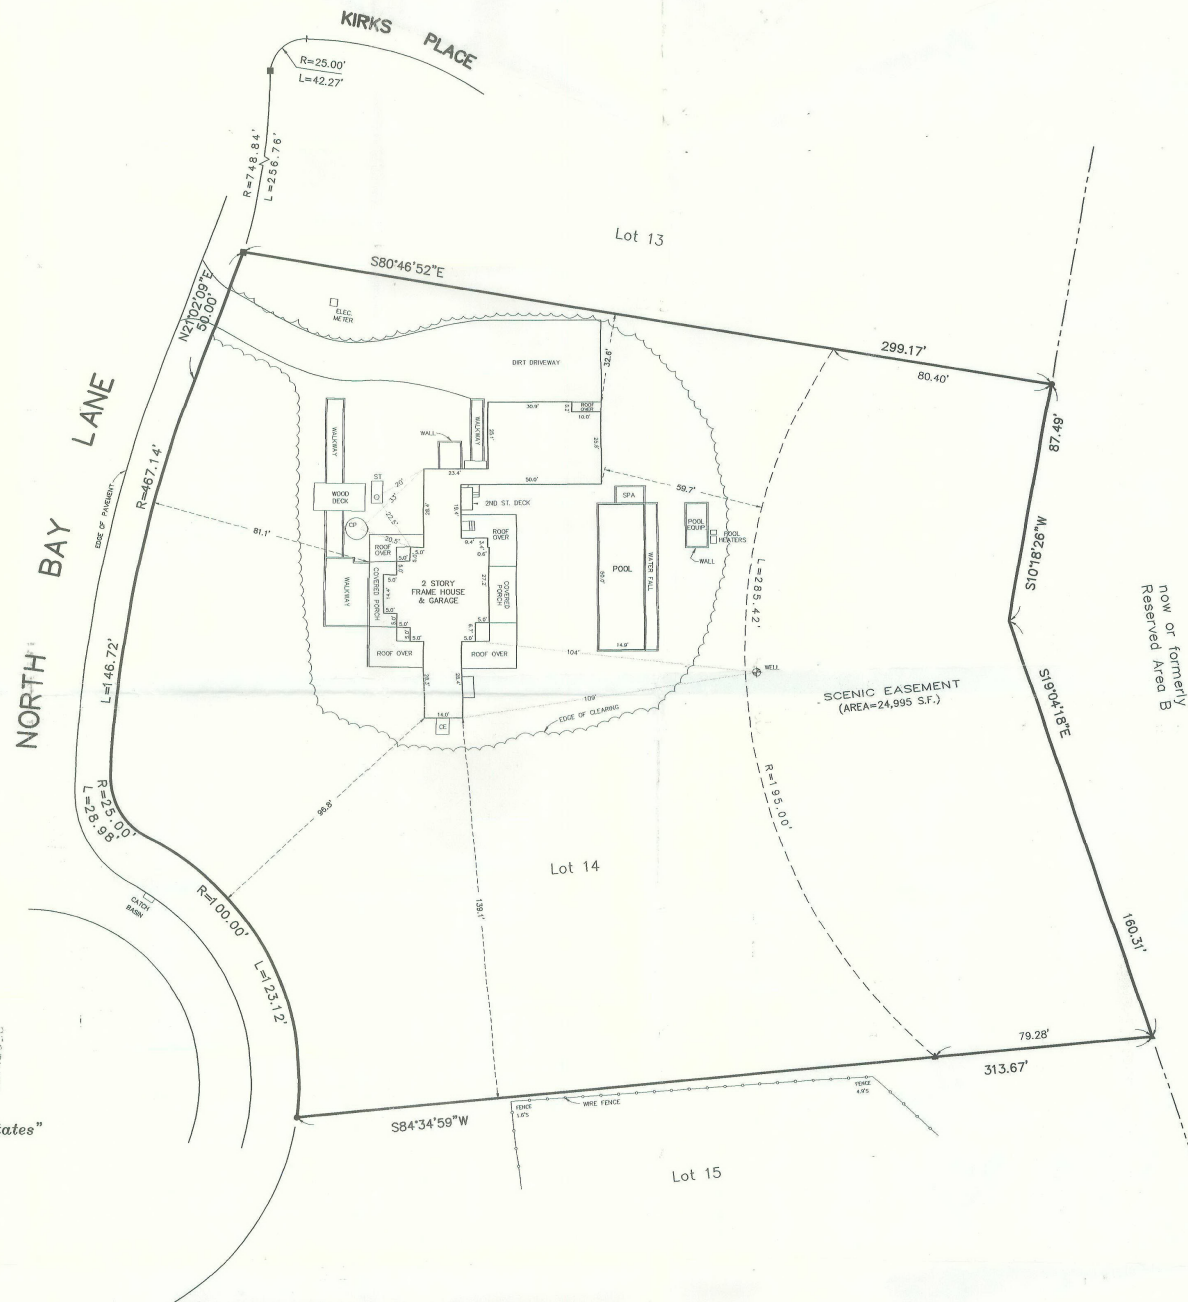

DWG: 990036