

UNAUTHORIZED ALTERATION OR ADDITIONS
TO THIS SURVEY IS A VIOLATION OF
SECTION 7209 OF THE NEW YORK STATE
EDUCATION LAW.

COPIES OF THIS SURVEY MAP NOT BEARING
THE LAND SURVEYOR'S GREEN EMBOSSED SEAL OR
EMBOSSED SEAL SHALL NOT BE CONSIDERED
TO BE A VALID TRUE COPY.

GUARANTEES INDICATED HEREON SHALL RUN ONLY TO THE PERSON FOR WHOM THE SURVEY IS PREPARED, AND ON HIS BEHALF TO THE TITLE COMPANY GOVERNMENTAL AGENCY AND LENDING INSTITUTION LISTED HEREON, AND TO THE ASSIGNEES OF THE LENDING INSTITUTION. GUARANTEES ARE NOT TRANSFERABLE TO ANY ADDITIONAL INSTITUTIONS OR SUBSEQUENT OWNERS.

025536

SUFFOLK COUNTY DEPARTMENT OF HEALTH SERVICES
SINGLE FAMILY DWELLING ONLY
DATE FEB 5 - 1988 U.S. REF. NO. 87SH-124
The sewage disposal and water supply facilities for this location have been inspected by this Department and/or other agencies and found to be satisfactory.
Stephen A. Costa, P.E.
Chief of Bureau of Wastewater Management

MAP OF PART OF LOT 14
SUBDIVISION MAP OF
COLD SPRING POND
MAP NO. 7202 FILED JULY 15, 1983

FOR
SALVATORE E JOANNE BARILE
SITUATE


WILZIECOCK HILLS
TOWN OF SOUTHAMPTON
SUFFOLK COUNTY, N. Y.
SCALE 1"=50'

AREA = 32,988 SQ. FT. REVISED JAN. 18, 1988 (FINAL)
SURVEYED OCT 24, 1985

Karl W. Weisenbach
SQUIRES, HOLDEN
WEISENBACHER, & SMITH
LAND SURVEYORS ~ ENGINEERS
SOUTHAMPTON ~ NEW YORK



<u>SUFFOLK COUNTY TAX MAP</u>	
DISTRICT	0900
SECTION	177.00
BLOCK	01.00
PARCEL	032.038

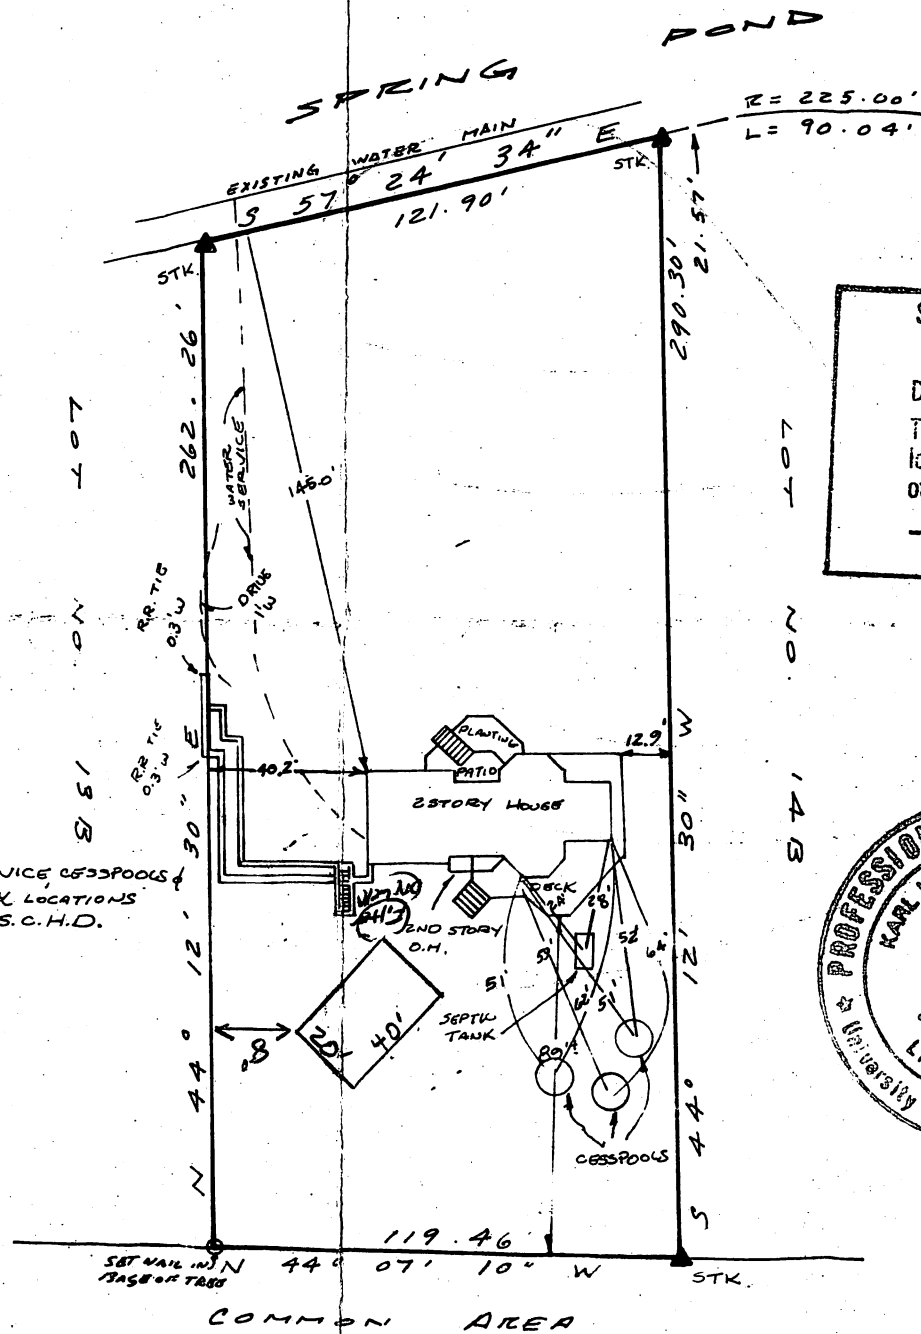

NOTE: WATER SERVICE, CESSPOOLS,
SEPTIC TANK LOCATIONS
AS PER S.C.H.D.