


SCALE: 1"=30'

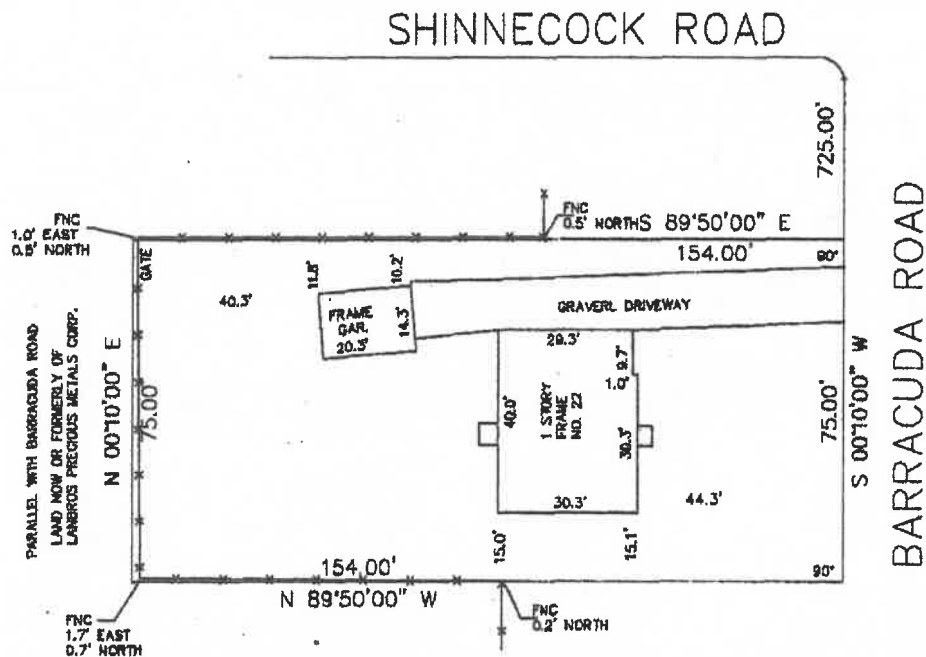

CERTIFIED TO:
BRIAN LERCH
BANK UNITED
FIRST AMERICAN TITLE INS. CO.
LANDS END ABSTRACT SERVICES LTD
TITLE NO. LE-930

MAP OF LOT NO. 11
AS SHOWN ON
"MAP OF SHINNICOCK SHORES, SECTION 1..."
SITUATED AT
EAST QUOGUE, TOWN OF SOUTHAMPTON
SUFFOLK COUNTY, NEW YORK

CONSTANCE PILNACEK, PLS
PO BOX 53
ST. JAMES, NY 11780
N.Y.S. LIC. NO. 50163
(631) 862-1111
DATE 4/24/15
REF. NO. 15-2912
UPDATE 5/28/15

MAP NO. 2040 FILED 5/19/1953
TAX MAP DESIGNATION: DISTRICT 0900 SECTION 362 BLOCK 02 LOT 030