


T. 1284-2941

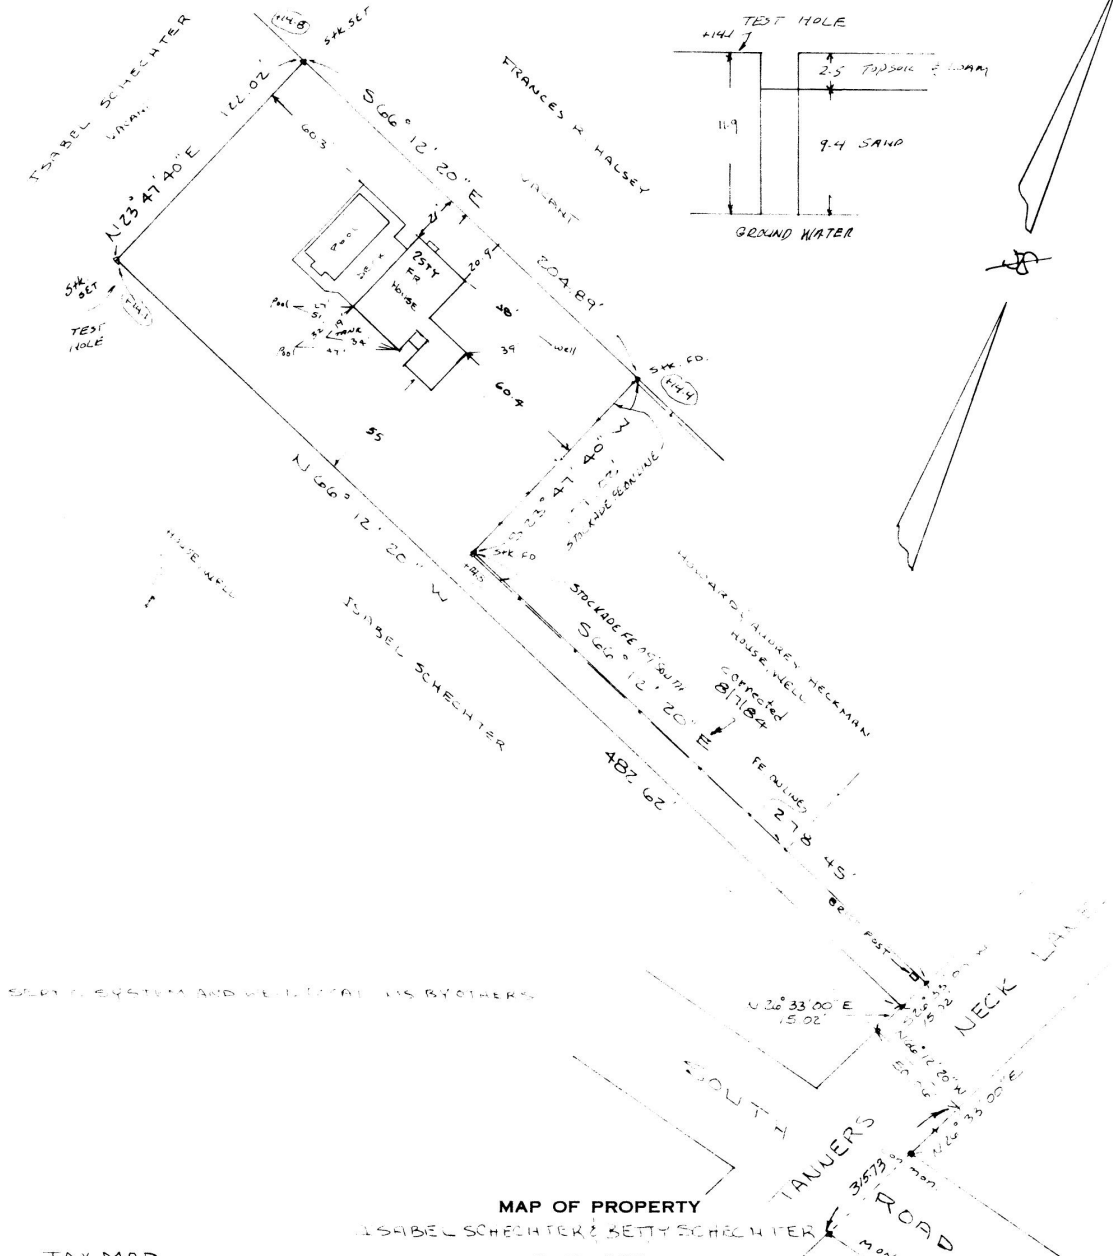

MAP OF PROPERTY
 ISABEL SCHECHTER & BETTY SCHECHTER
 SITUATE
 WESTHAMPTON
 TOWN OF SOUTHAMPTON - SUFFOLK COUNTY, N.Y.

TAX MAP
 DISTRICT 0900
 SECTION 369
 BLOCK 03
 LOT 09

SURVEYED: AUG 3, 1984 - SCALE: 1" INCH = 50 FEET
 UNDER CONST 4122185
 FINAL: JULY 8, 1985

C-9322

UNAUTHORIZED ALTERATION OR ADDITION
 TO THIS SURVEY IS A VIOLATION OF
 SECTION 7209 OF THE NEW YORK STATE
 EDUCATION LAW.

COPIES OF THIS SURVEY MAP NOT BEARING
 THE LAND SURVEYOR'S INKED SEAL OR
 EMBOSSED SEAL SHALL NOT BE CONSIDERED
 TO BE A VALID TRUE COPY.

GUARANTEES INDICATED HEREON SHALL RUN
 ONLY TO THE PERSON FOR WHOM THE SURVEY
 IS PREPARED, AND ON HIS BEHALF TO THE
 TITLE COMPANY, GOVERNMENTAL AGENCY AND
 LENDING INSTITUTION LISTED HEREON AND
 TO THE ASSIGNEES OF THE LENDING INSTI-
 TUTION. GUARANTEES ARE NOT TRANSFERABLE
 TO ADDITIONAL INSTITUTIONS OR SUBSEQUENT
 OWNERS.

SUFFOLK COUNTY HEALTH DEPARTMENT

DATE JUL 26 1985 R. D. REF. #1454-677

The sewage disposal and water supply
 facilities for this location have been
 inspected by this department and found
 to be satisfactory.

Stephen A. Costa, P.E.
 Chief of General Engineering
 Services

CERTIFIED TO:
 SOUTHOLD SAVING & BANK
 THE TITLE GUARANTEE CO.



RAYNOR & MARCKS
 SURVEYING & ENGINEERING
 QUOGUE, N.Y.

■ CONCRETE MONUMENT
 ▲ WOOD STAKE
 BK. TO PG. 26
 AREA 29,172 Sq Ft

Stephen M. Marcks, L.S. 49583