

JOB No. 13652 ~ D4047

SUFFOLK COUNTY TAX MAP

DISTRICT	0900
SECTION	77.00
BLOCK	05.00
PARCEL	033.000


TEST HOLE DUG 10/28/02

1'	OL	BROWN SANDY LOAM
8'	SM	BROWN SILTY SAND
8'	SP	PALE BROWN FINE TO MEDIUM SAND

TEST HOLE DATA
NOT TO SCALE

NOTES

1. DATUM IS IN N.G.V.D. OF 1929.
2. THERE ARE NO KNOWN WELLS WITHIN 150' OF PROPOSED CESSPOOLS. THERE ARE NO KNOWN CESSPOOLS WITHIN 150' OF PROPOSED WELL.
3. PROPOSED CLEARED AREA MEASURES 14,500 S.F.
4. A WATER MAIN IS PROPOSED IN THE R.O.W. OF STRAIGHT PATH. ONCE THIS MAIN IS INSTALLED, THE HOUSE WILL BE CONNECTED TO PUBLIC WATER.

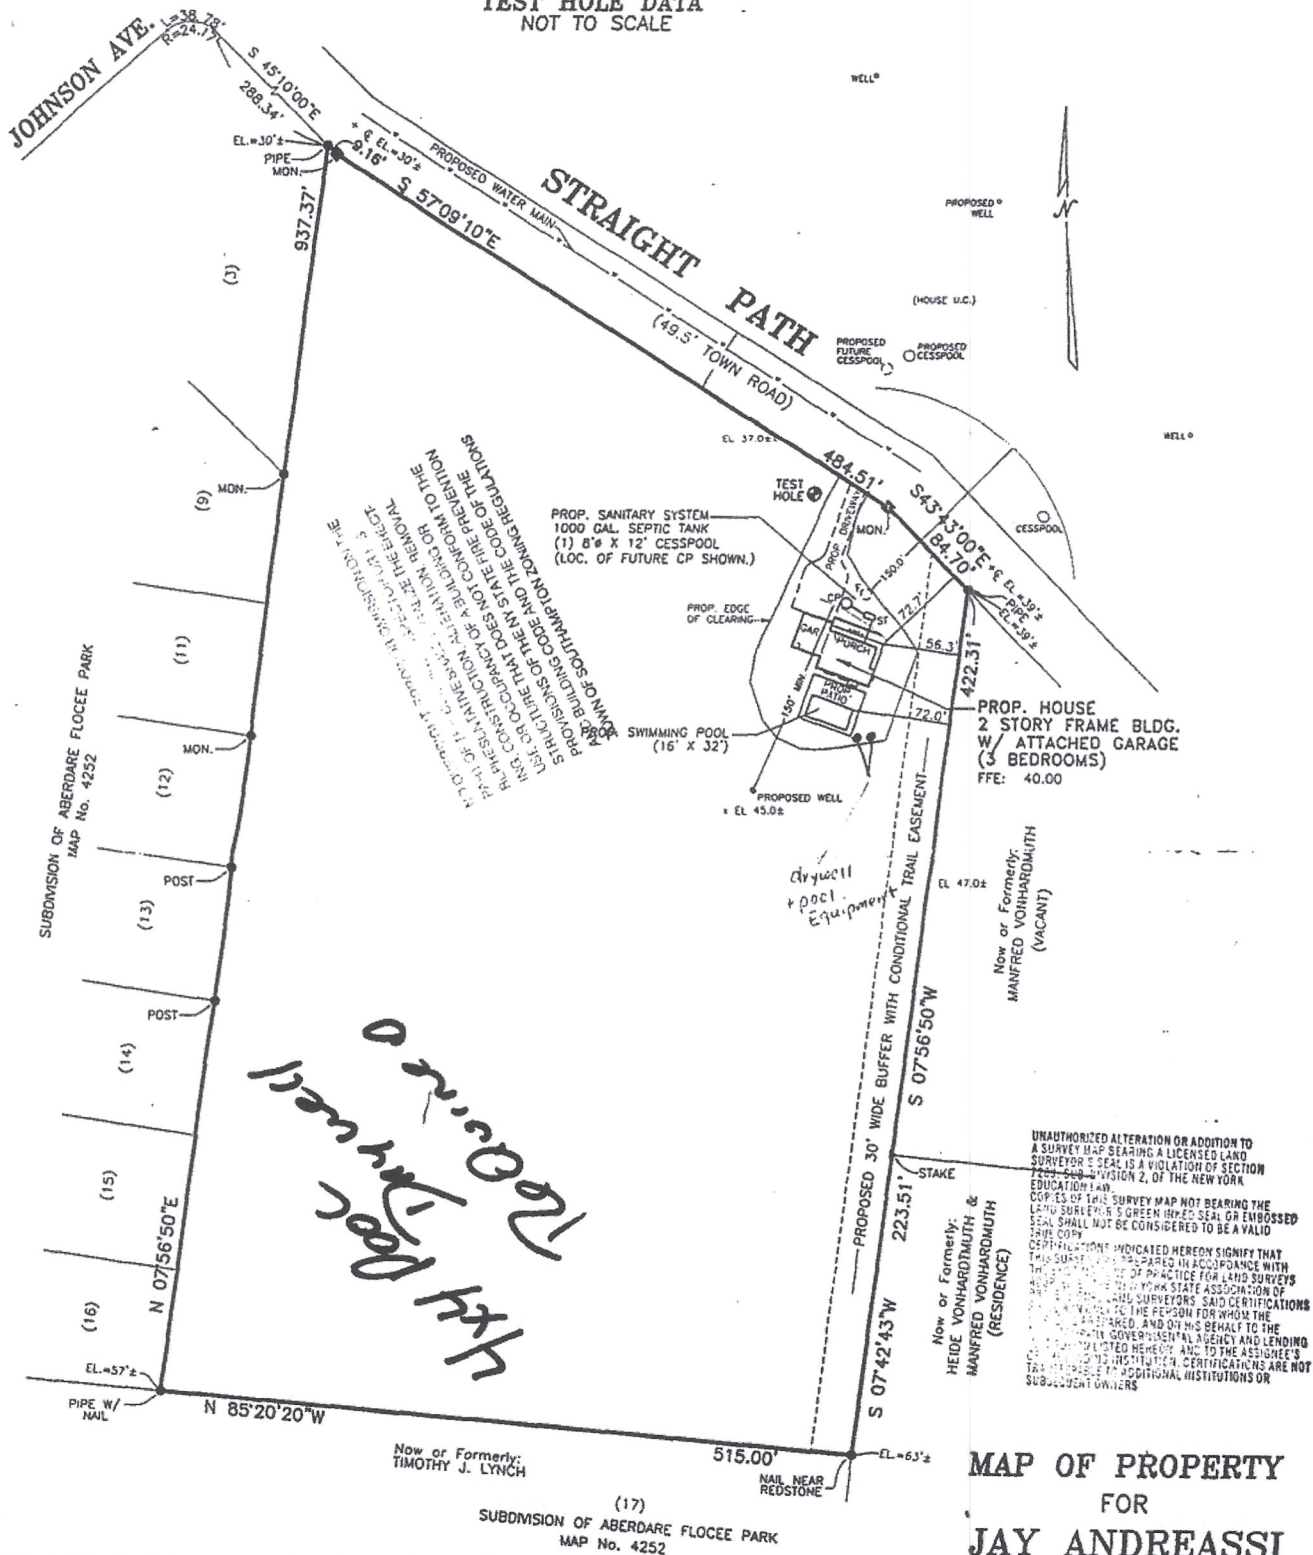

REVISED: MARCH 3, 2003 (PROP. HOUSE, POOL & PATIO)
 REVISED: JANUARY 22, 2003 (PROP. BUFFER)
 REVISED: NOVEMBER 14, 2002 (TEST HOLE, ETC...)
 MAP PREPARED: SEPT. 18, 2002 (FROM OFFICE RECORDS)

LOCAL LAND SURVEYOR
 R. A. SMITH

MAP OF PROPERTY
 FOR
JAY ANDREASSI
 SITUATE
NORTH SEA
 TOWN OF SOUTHAMPTON