

GROUND ELEVATION

ELEVATION DATUM ASSUMED

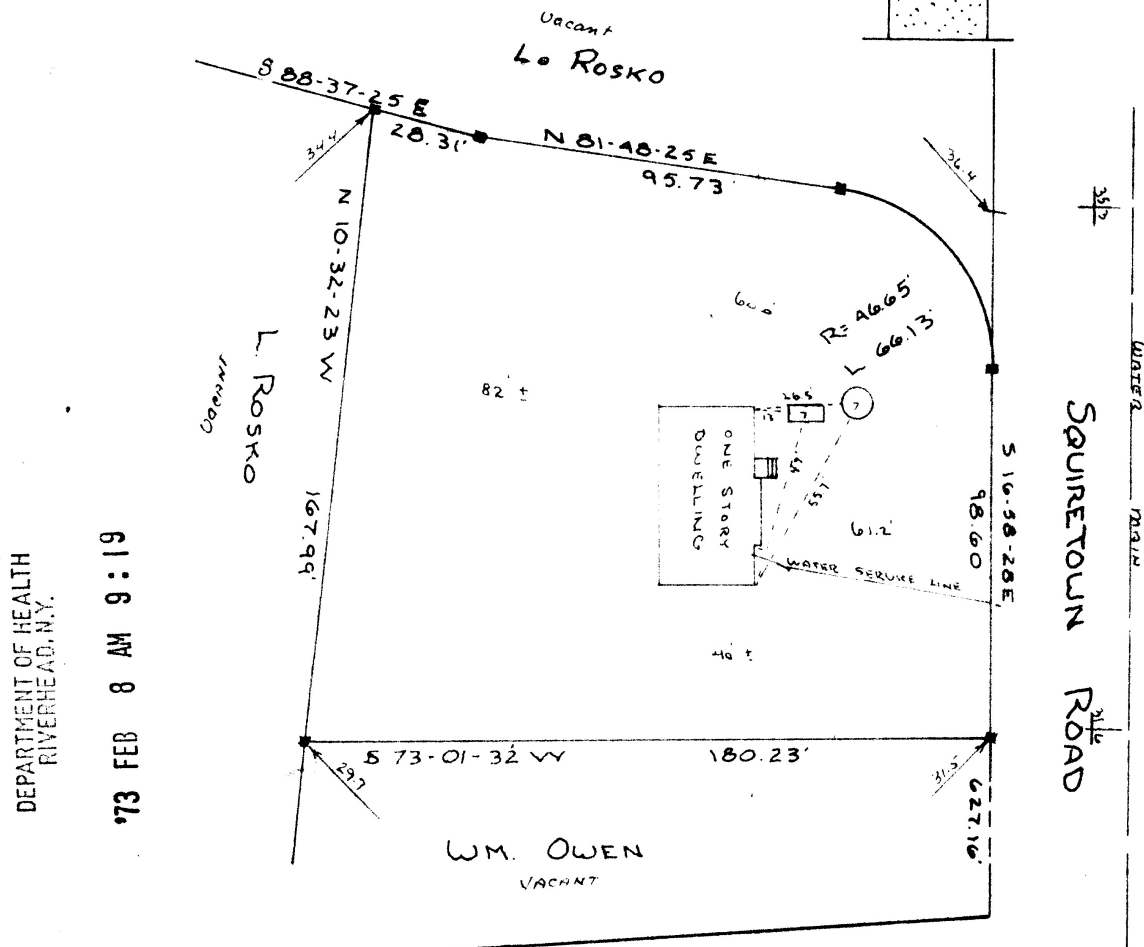
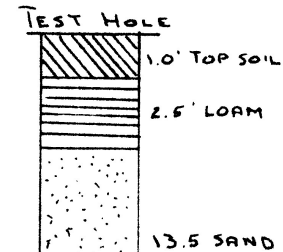


SUFFOLK COUNTY HEALTH DEPARTMENT

DATE FEB 8 1973 H. D. REC. # 54-5742

The sewage disposal soil water quality
for this property has been
inspected and found to be
to be satisfactory.

Robert A. Villa
Chief of General Engineering
Services

SURVEY OF PROPERTY MONTAUK
SITUATE

SQUIRETOWN ROAD

HAMPTON BAYS

TOWN OF SOUTHAMPTON
SUFFOLK COUNTY NEW YORK

CERTIFIED TO:

STEVEN + DEBIE MICARI

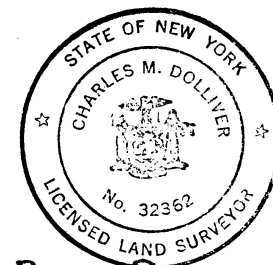
SAG HARBOR SAVINGS BANK

THE TITLE GUARANTEE CO.

LICENSE No 32362

Charles M. Dolliver

LICENSE No 47400



BYRNE DOLLIVER ASSOC.

ENGINEERS - LAND SURVEYORS

HAMPTON BAYS, N.Y.

SCALE 1" = 40' SURVEYED November 15, 1972 REVISED DEC 27, 1972 & FEB 5, 1973 83 113
 DENOTES MONUMENTS A DENOTES STAKES BK 85 PG 107