

LOT AREA: 46,701 SQ.FT. = 1.072 ACRE
PROPERTY IS 100% CLEARED

FLOOD ZONE BOUNDARIES HEREON AS SCALED FROM THE F.E.M.A.
FLOOD INSURANCE RATE MAP - MAP NO.: 36103C0516 H
EFFECTIVE DATE: SEPTEMBER 25, 2009

TEL: (631)-369-8312 - FAX: (631)-369-8313
MARTIN D. HAND L.S



COPIES OF THIS SURVEY MAP, EITHER PAPER OR ELECTRONIC, NOT BEARING THE LAND SURVEYORS INKED SEAL OR EMBOSSED SEAL SHALL NOT BE CONSIDERED TO BE A VALID COPY AND SHALL NOT BE USED FOR ANY PURPOSE.

LICENSE NO. 050363

SANITARY TRIANGULATION DIMENSIONS

	S.T.	CP1	CP 2	4" C/O
CORNER A	102'	122'	123'-6"	44'
CORNER B	116'	133'	129'-6"	70'

SANITARY DIMENSIONS AS RECEIVED FROM INSTALLER
WATER SERVICE LOCATION AS RECEIVED FROM INSTALLER.


BASEMENT AND/OR SUBSURFACE STRUCTURES RECORDED OR UNRECORDED ARE NOT GUARANTEED UNLESS PHYSICALLY EVIDENT AT THE TIME OF SURVEY.

THE OFFSET (FOR DIMENSIONS) SHOWN HEREON FROM THE STRUCTURES TO THE PROPERTY LINES ARE FOR A SPECIFIC PURPOSE, TO USE AND FOR THE RECORD. THESE LINES ARE NOT INTENDED TO GUIDE THE ERECTION OF FENCES, WALLS, POLES, RATIOS, PLANTING ADJUSTMENTS, OR ANY OTHER CONSTRUCTION.

UNAUTHORIZED ALTERATION OR ADDITION TO THIS SURVEY IS A VIOLATION OF SECTION 130 OF THE NEW YORK STATE EDUCATION LAW.


COPIES OF THIS SURVEY MAP NOT BEARING THE SURVEYOR'S SEAL OR SIGNATURE OR EMOSSUED SEAL SHALL NOT BE CONSIDERED TO BE A VALID TYPE COPY.

CERTIFICATIONS INCORPORATED HEREON SHALL RUN AND BE VALID FOR WHATEVER PERIOD THIS SURVEY IS PREPARED AND ON HIS BEHALF TO THE SURVEYOR, THE SURVEYOR'S EMPLOYER AND LENDOR INSTITUTION LISTED HEREON, AND TO ANY OTHER PERSONS TO WHOM THE SURVEY OR TUTION. CERTIFICATIONS ARE NOT TRANSFERABLE TO ADDITIONAL INSTITUTIONS OR SUBJECTS OWNED OR CONTROLLED BY THE SAME PERSON.

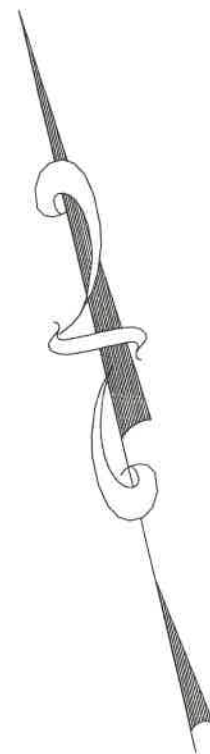

SURVEY OF
DESCRIBED PROPERTY
SITUATE
NORTH SEA
TOWN OF SOUTHAMPTON
SUFFOLK COUNTY, NEW YORK

S.C.T.M. DIST. 0900 SEC.60 BLK.01 LOT 25

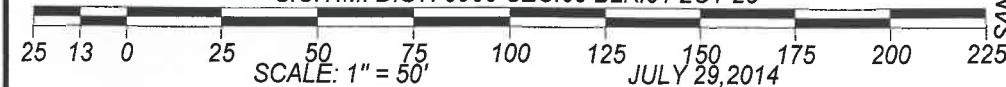

**IMPROVED
SANITARY AREA AS SHOWN
WELL IN EXCESS OF 150'**

