


LOT NUMBERS FROM MAP
OF VANDERBILT PARK
SECT 6+7 BLOCK B FILED
JAN 27, 1910 AS MAP # 655

SUMMIT BOULEVARD

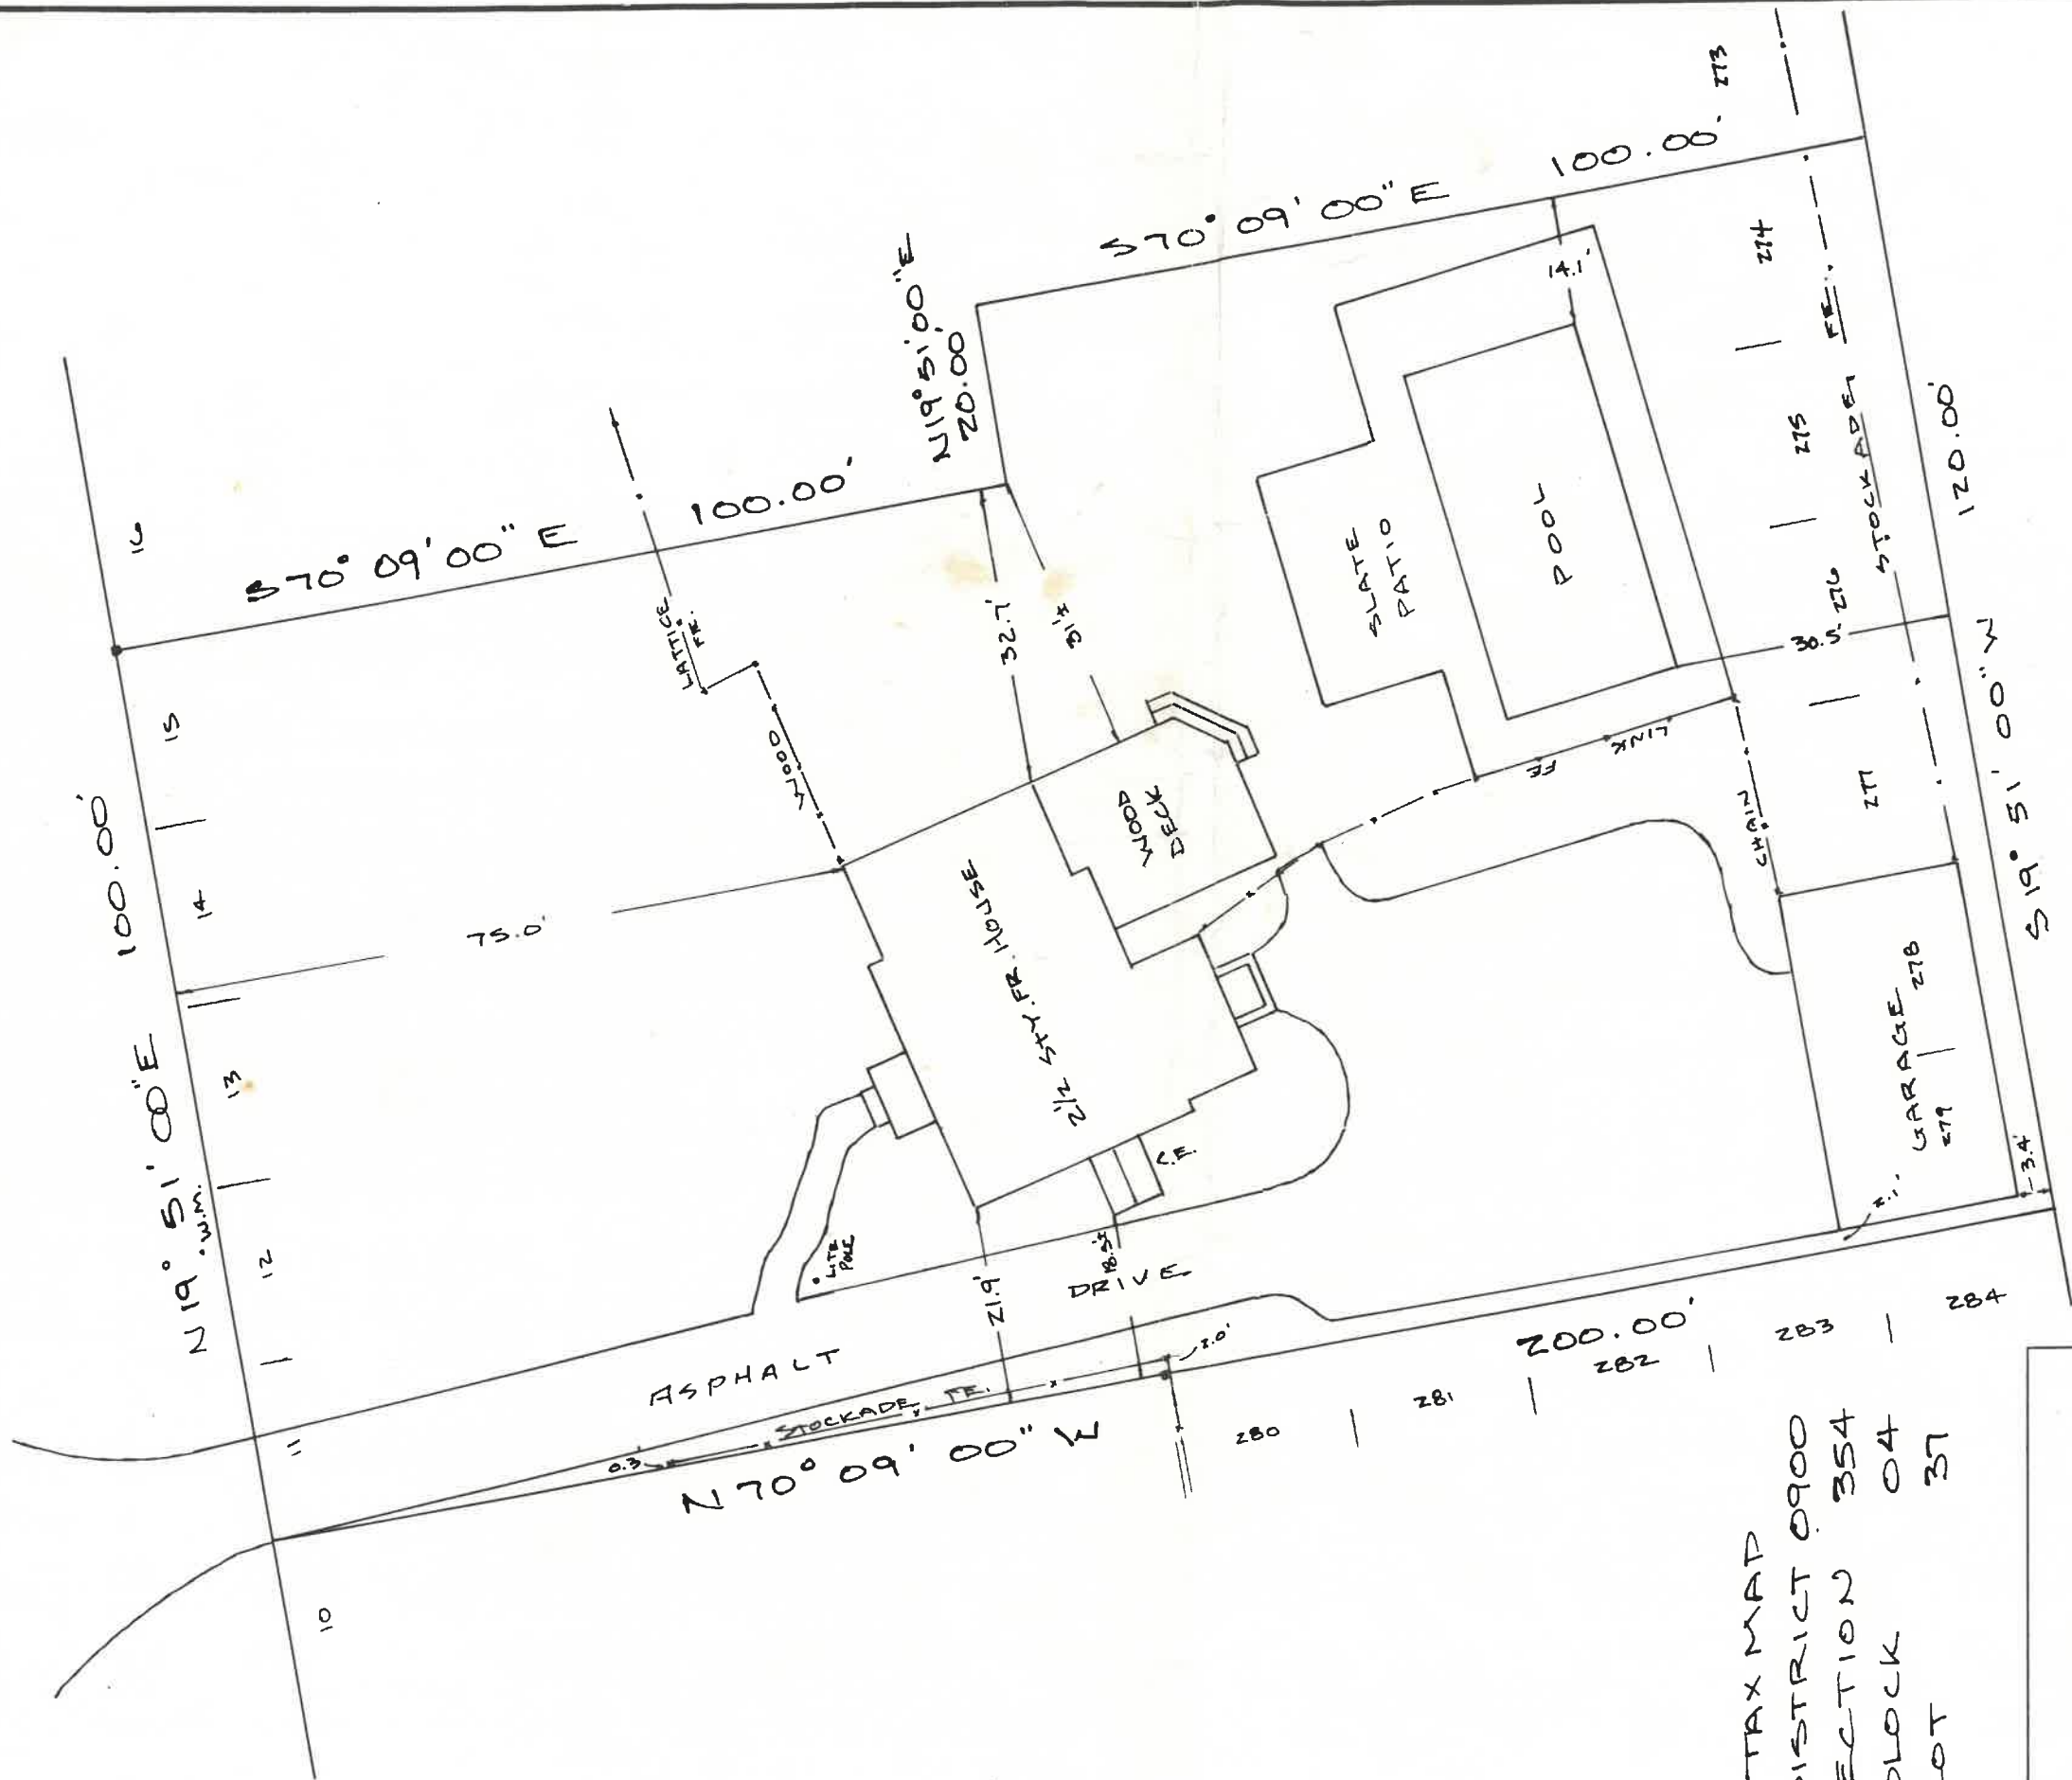

TAX MAP
DISTRICT 0900
SECTION 354
BLOCK 04
LOT 37

UNAUTHORIZED ALTERATION OR ADDITION TO A SURVEY MAP BEARING A LICENSED LAND SURVEYOR'S SEAL IS A VIOLATION OF SECTION 7209, SUB-DIVISION 2, OF THE NEW YORK STATE EDUCATION LAW.
ONLY COPIES FROM THE ORIGINAL OF THIS SURVEY MARKED WITH AN ORIGINAL OF THE LAND SURVEYOR'S INKED SEAL OR EMBOSSED SEAL SHALL BE CONSIDERED TO BE VALID TRUE COPIES.
CERTIFICATIONS INDICATED HEREON SHALL RUN ONLY TO THE PERSON FOR WHOM THE SURVEY IS PREPARED, AND ON HIS BEHALF TO THE TITLE COMPANY, GOVERNMENTAL AGENCY AND LENDING INSTITUTION LISTED HEREON, AND TO THE ASSIGNEES OF THE LENDING INSTITUTION. CERTIFICATIONS ARE NOT TRANSFERABLE TO ADDITIONAL INSTITUTIONS OR SUBSEQUENT OWNERS.

RAYNOR & MARCKS
SURVEYORS, P.C.
QUOGUE, N.Y.
516-653-4066

MAP OF PROPERTY
PAUL KNESKI
SITUATE

WEST HAMPTON
TOWN OF SOUTHAMPTON - SUFFOLK CO., N.Y.
SURVEYED: OCT 27, 1998



■ - CONCRETE MONUMENT
△ - WOOD STAKE
BK. 22 PG. 19
AREA - 22,000 SQ.FT.