



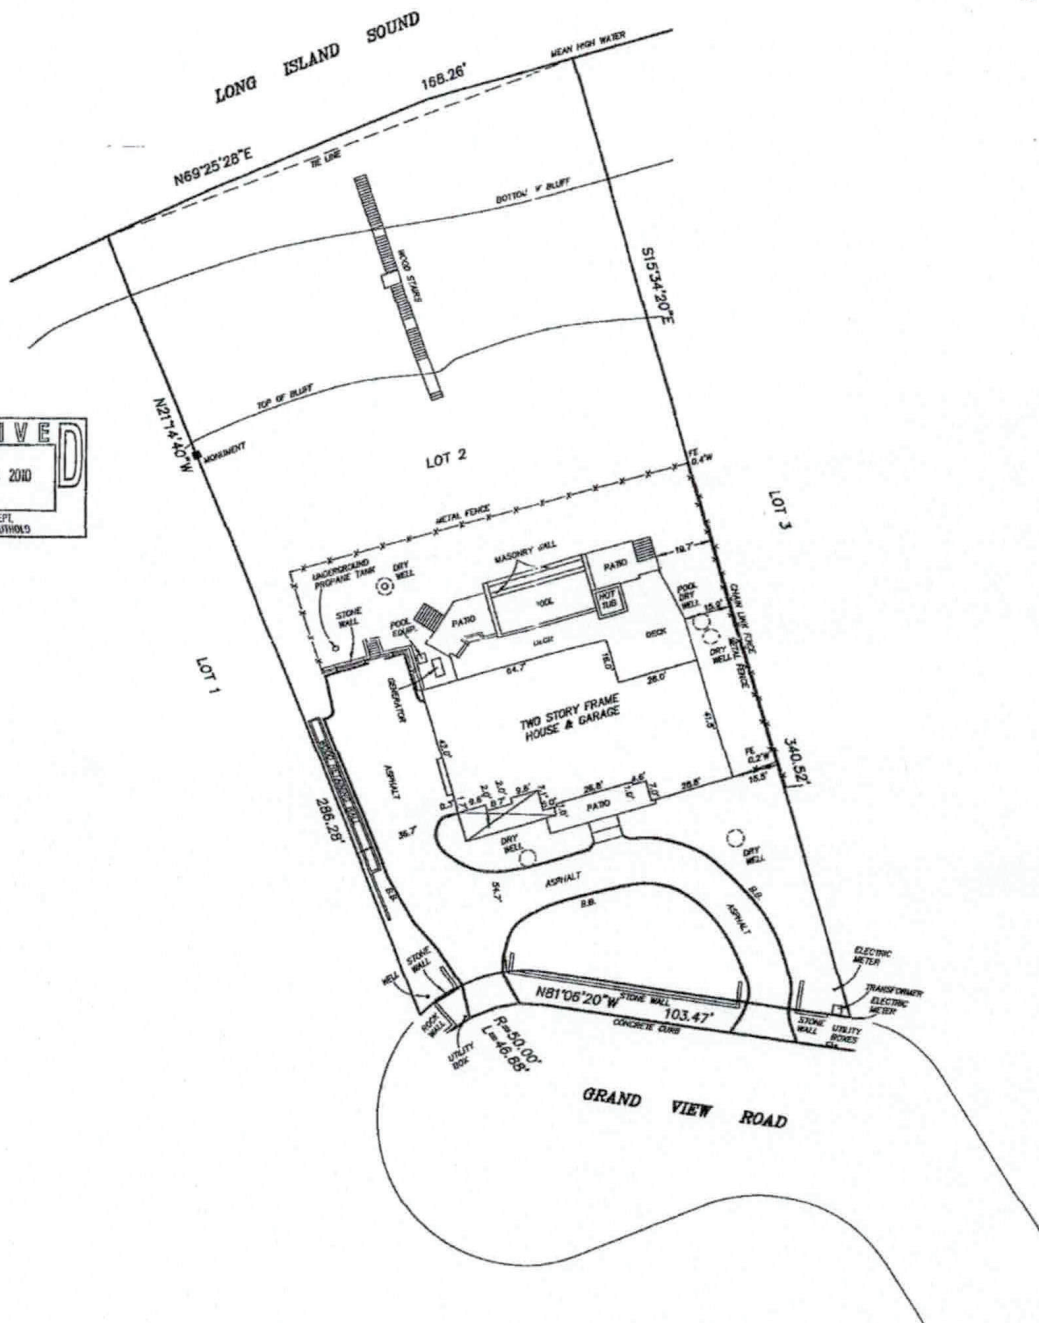

SURVEY OF PROPERTY
AT ORIENT
TOWN OF SOUTHOOLD
SUFFOLK COUNTY, N.Y.
1000-14-02-3.6
SCALE: 1"=30'
SEPTEMBER 1, 2010

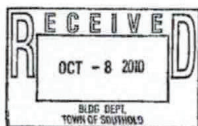

AREA=46,583 SQ. FT.
TO TIE LINE

LOT NUMBERS REFER TO "MAP OF GRAND VIEW ESTATES"
FILED IN THE SUFFOLK COUNTY CLERK'S OFFICE ON
JUNE 8, 1982 AS FILE NO. 7083.

DRY WELL LOCATION FROM OTHERS.

ANY ALTERATION OR ADDITION TO THIS SURVEY IS A VIOLATION
OF SECTION 7208(6) OF THE NEW YORK STATE EDUCATION LAW.
EXCEPT AS PER SECTION 7208-SUBDIVISION 2. ALL CERTIFICATIONS
HEREON ARE VALID FOR THIS MAP AND COPIES THEREOF ONLY IF
SAID MAP OR COPIES BEAR THE IMPRESSED SEAL OF THE SURVEYOR
WHOSE SIGNATURE APPEARS HEREON.



10-118