


TOTAL COVERAGE
ALLOWED - 16,574 SF.
EXISTING - 8,910 SF.

CLEARING
ALLOWED - 20,359 SF
EXISTING - 15,537 SF

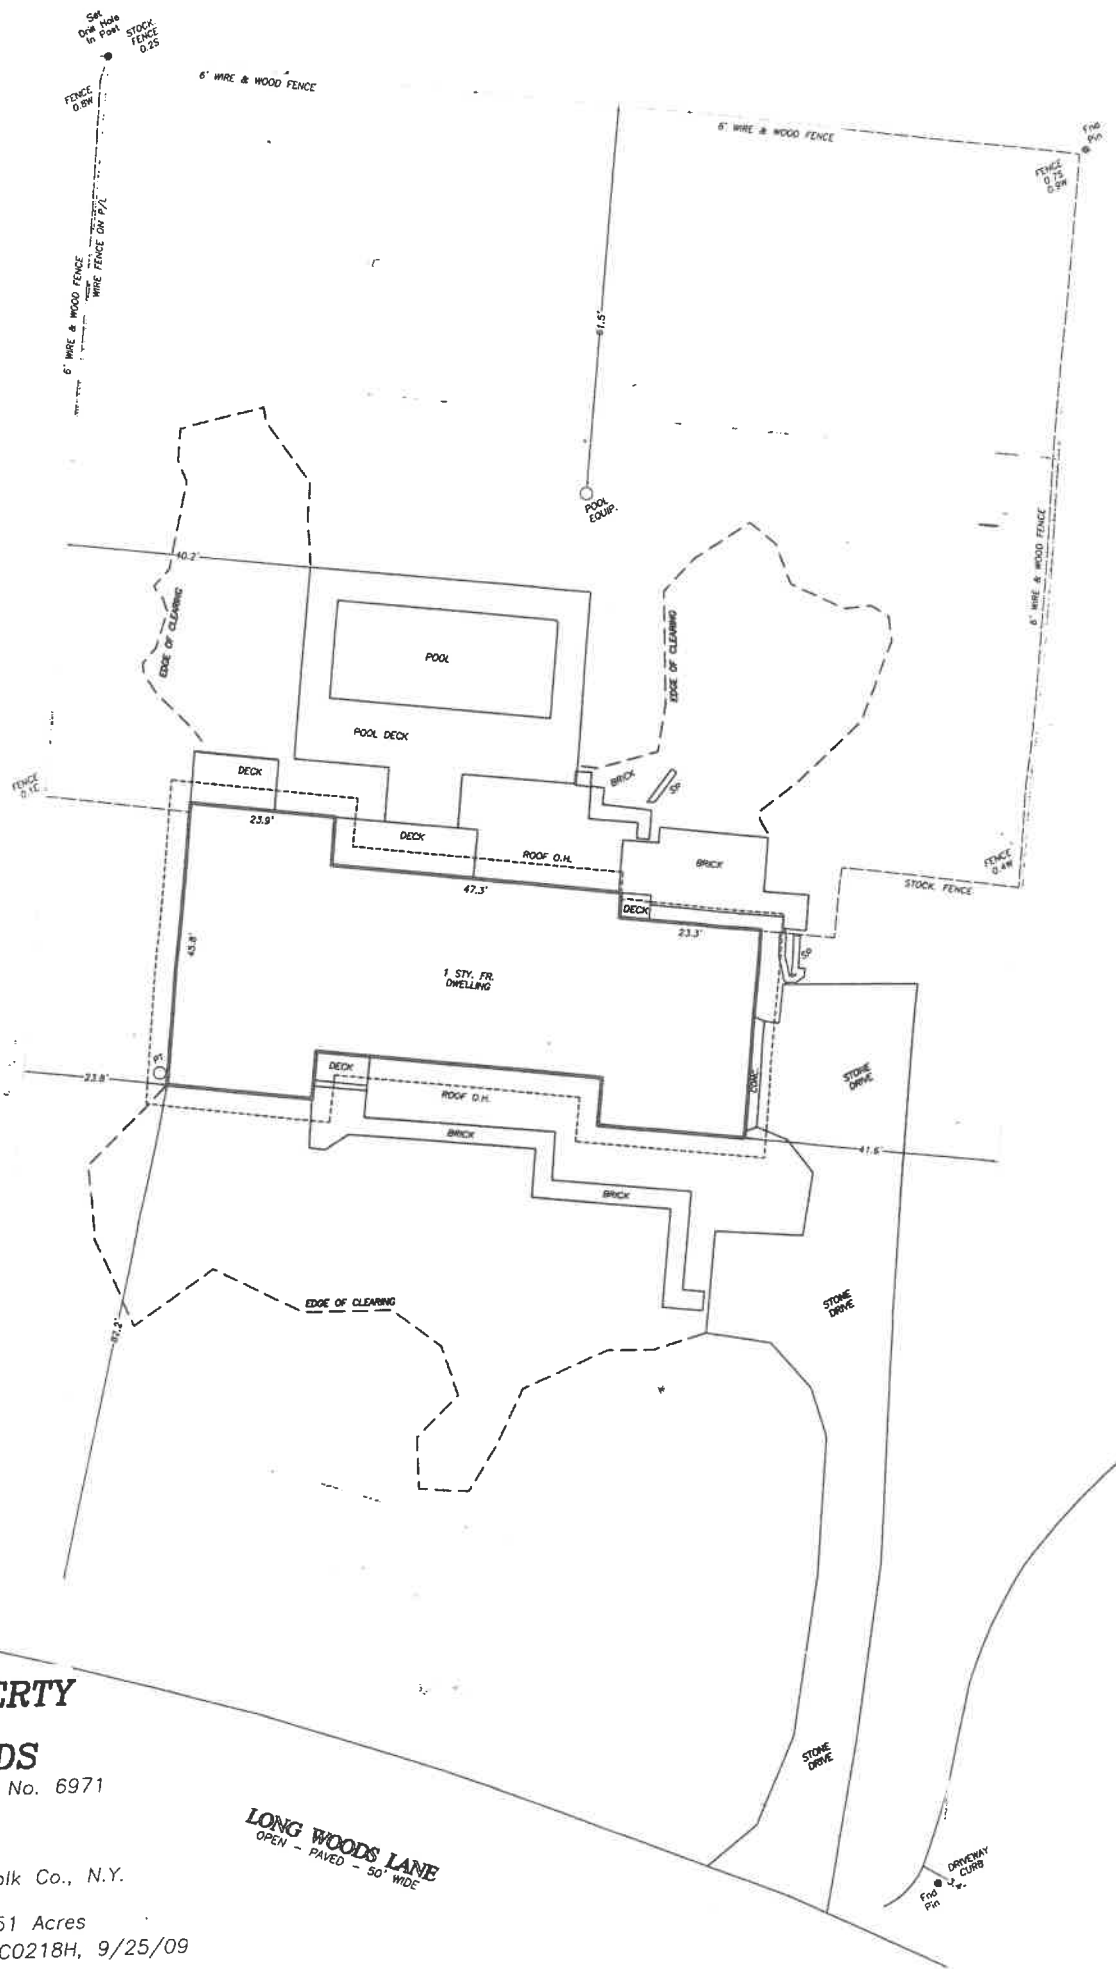

LOT 11
SPRING WOODS

SITUATE

SPRINGS

Scale: 1"=20'

d Zone: X - FIRM NO. 36103C0218H, 9/25/09