

S.C.T.M. NO. 600 - 35 - 6 - 34.1
SURVEY OF:
DESCRIBED PROPERTY


SITUATED IN: WADING RIVER
TOWN OF: RIVERHEAD
SUFFOLK COUNTY, NEW YORK
DATE: 5/19/2021
JOB NO. G21-7004
SCALE: 1" = 20'

GUARANTEES INDICATED SHALL RUN ONLY TO THE PERSON FOR WHOM THE SURVEY IS PREPARED AND/OR AGENCY, AND ARE NOT TRANSFERABLE.

CERTIFIED TO:

Kirk Lehman

GARY BENZ, L.S.
Surveying and Land Planning
527-B Hawkins Avenue
Ronkonkoma, N.Y. 11779
GaryBenzLS@yahoo.com
(631) 648-8348

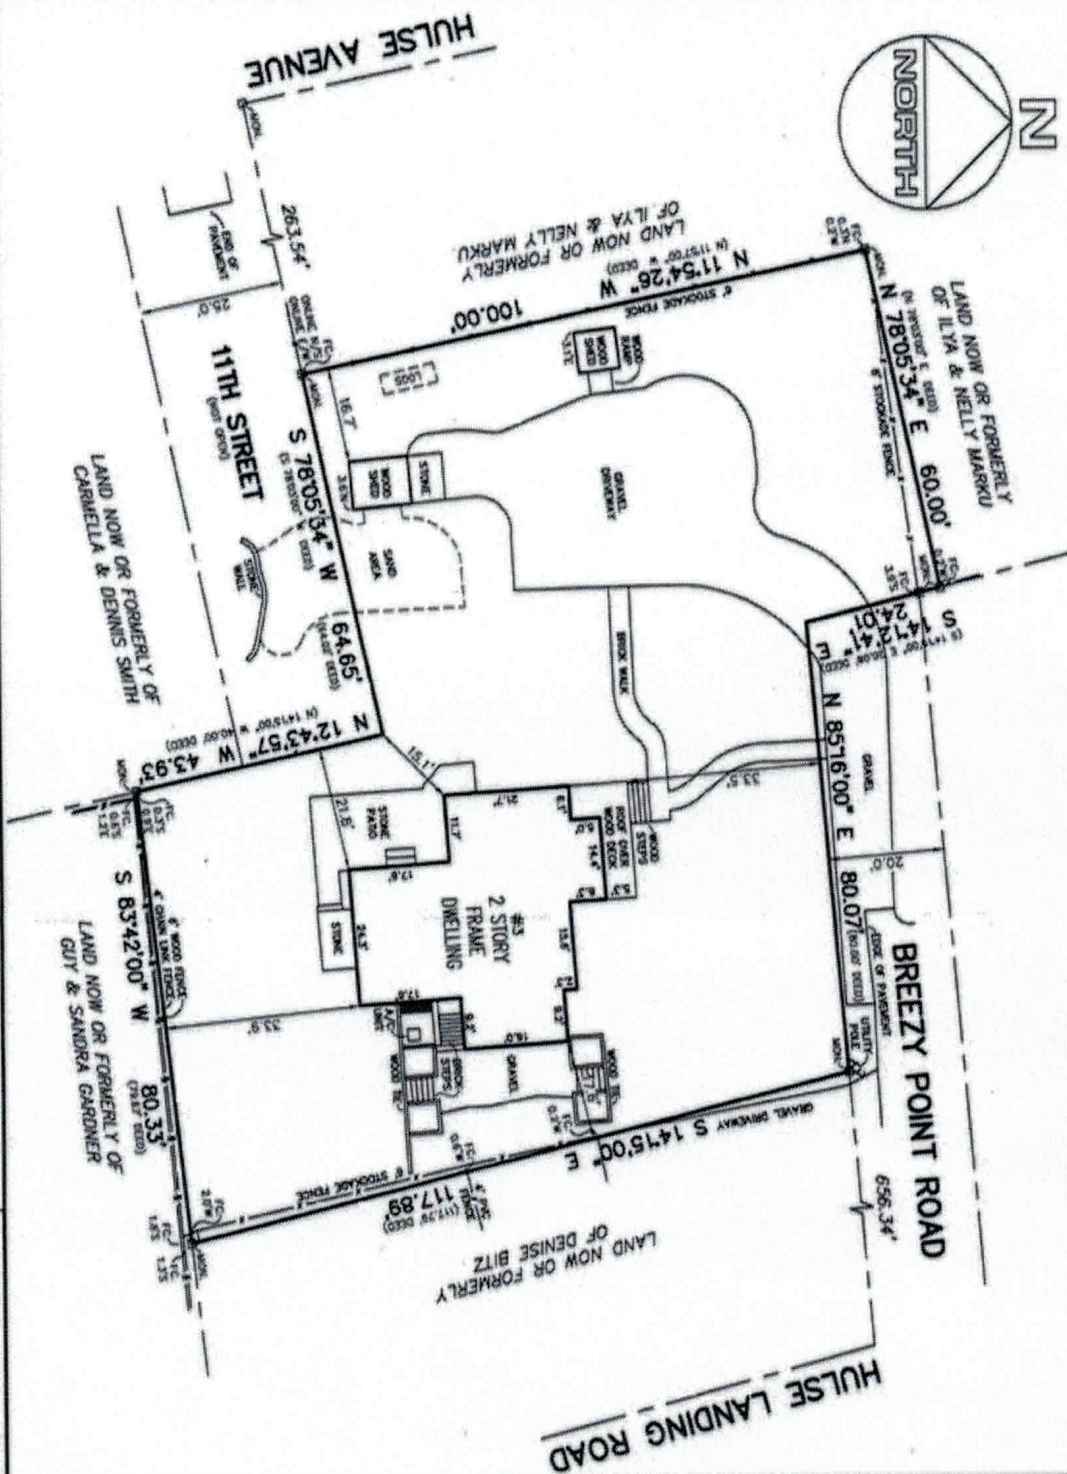

THE EXISTENCE OF RIGHT OF WAYS, WETLANDS, UNDERGROUND UTILITIES AND/OR EASEMENTS OF RECORD IF ANY, NOT SHOWN ARE NOT GUARANTEED.

UNAUTHORIZED ALTERATION OR ADDITION TO THIS SURVEY IS A VIOLATION OF SECTION 7209 OF THE NEW YORK STATE EDUCATION LAW

COPIES OF THIS SURVEY MAP NOT BEARING THE LAND SURVEYOR'S PINKED SEAL OR EMBOSSED SEAL SHALL NOT BE CONSIDERED TO BE A VALID TRUE COPY.