

N 25°08'50" W 105.00'

LAND N/F 6500 MAIN RD EAST MARION LLC


N 64°51'10" E 100.00'

LAND N/F TOWN OF SOUTHBOLD

N 64°51'10" E 100.00'

	A	B	C
I/A SEPTIC	14'	19.5'	26.5'
D.B.			44.5'
LG1	43'	17'	
LG2	47'	24.5'	
LG3	33.5'	13.5'	
LG4	38.5'	22.5'	

SANITARY LOCATION CHART

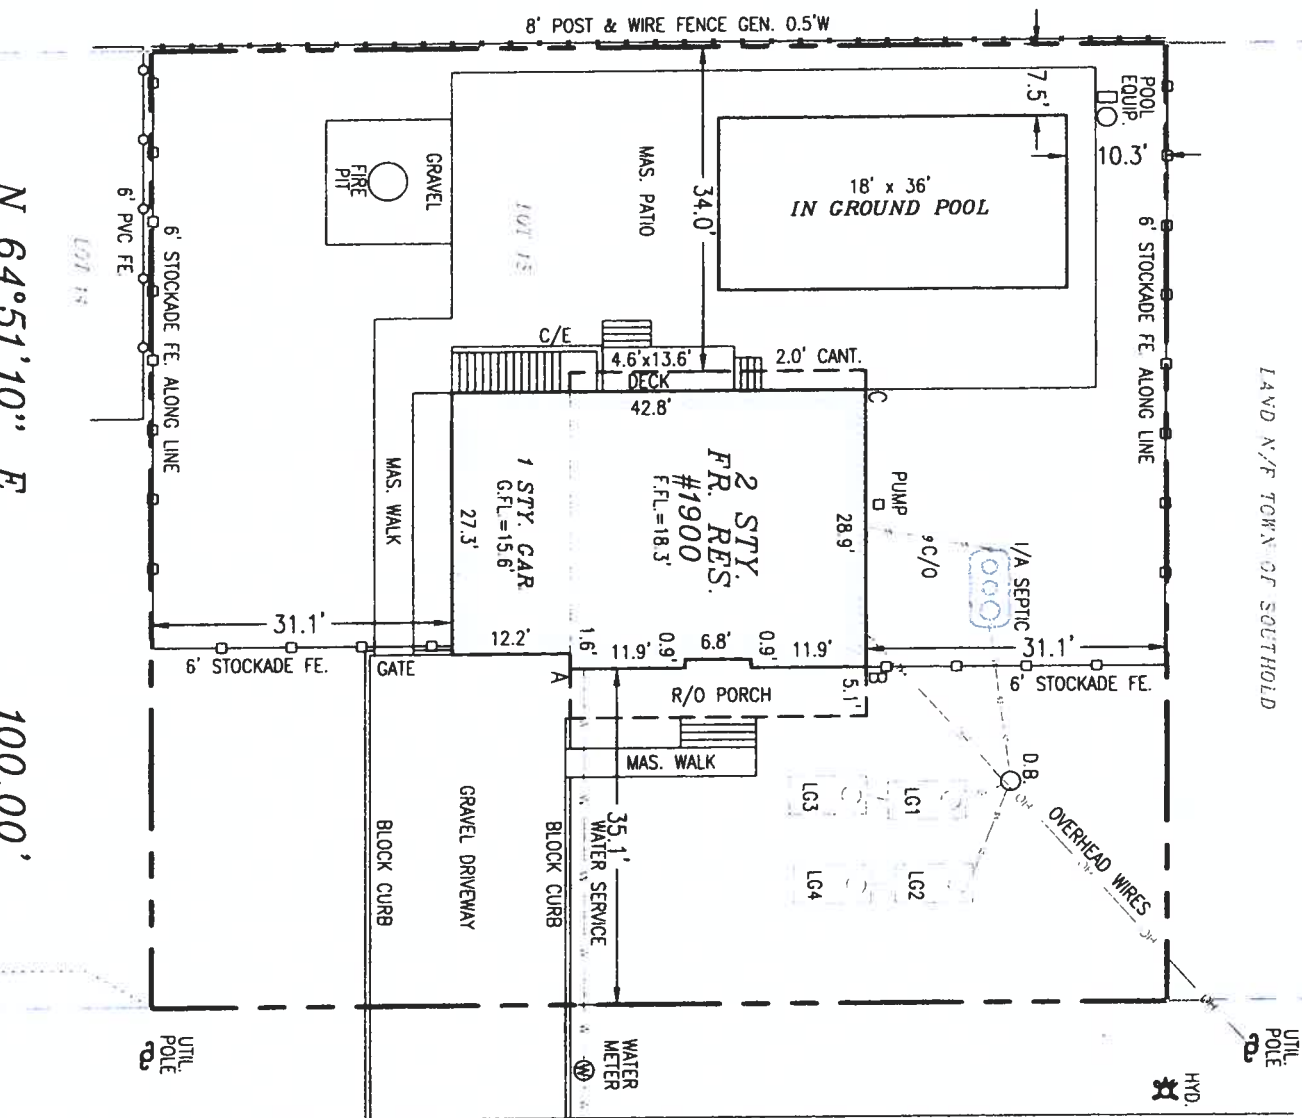

S 25°08'50" E 105.00'
GILLETTE DRIVE

CLEAVES POINT ROAD

MIDLAND PLACE

JOSHUA R. WICKS P.L.S.

SURVEYED BY: J.R.W.

DRAWN BY: D.T.O.

JOB NO: JRW25-0114


P.O. BOX 593

Center Moriches, N.Y. 11934

JoshuaRicks@gmail.com

#631-405-8108

GRAPHIC SCALE

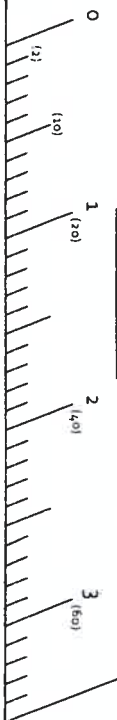

SURVEY OF PROPERTY

Marion Manor

5000 MARION RD - MARION, NY 11934

5.4 AC

EAST MARION TOWN OF SOUTHOLD, NY

5.5500 AC (5.5500 AC) NEW YORK

Suffolk County Tax Map No.

1000-03800-0200-020000

SUFFOLK COUNTY DEPARTMENT OF HEALTH SERVICES

APPROVAL OF CONSTRUCTED WORKS FOR

A SINGLE FAMILY RESIDENCE

Date: SEP 10 2025

H.S. 904.100 R-24-1123

The sewage disposal and water supply facilities at this location have been inspected and/or approved by this department or other agencies and found to be satisfactory for a maximum of 4 bedrooms.

JONATHAN PAI, P.E., CHIEF

OFFICE OF WASTE MANAGEMENT

JP

NOTE:

NO VISIBLE WELLS WITHIN 150' OF SUBJECT PROPERTY

LOT AREA


10,500.00 S.F.

0.24 ACRE(S)

NOTE:

ALL UNDER GROUND UTILITY LOCATIONS AND SIZES PROVIDED BY OTHERS

* ALL ELEVATIONS REFER TO NAVD88 DATUM

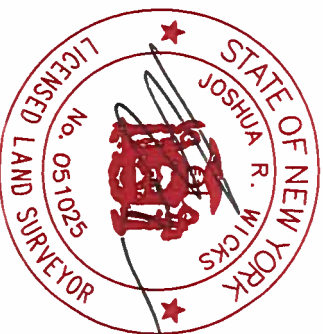

CHECKED BY: