


11
 TEMBER 12, 1893, FILE No. 506
 EAST HAMPTON
 COUNTY, NEW YORK
 32-002-07-18
 32. FT.

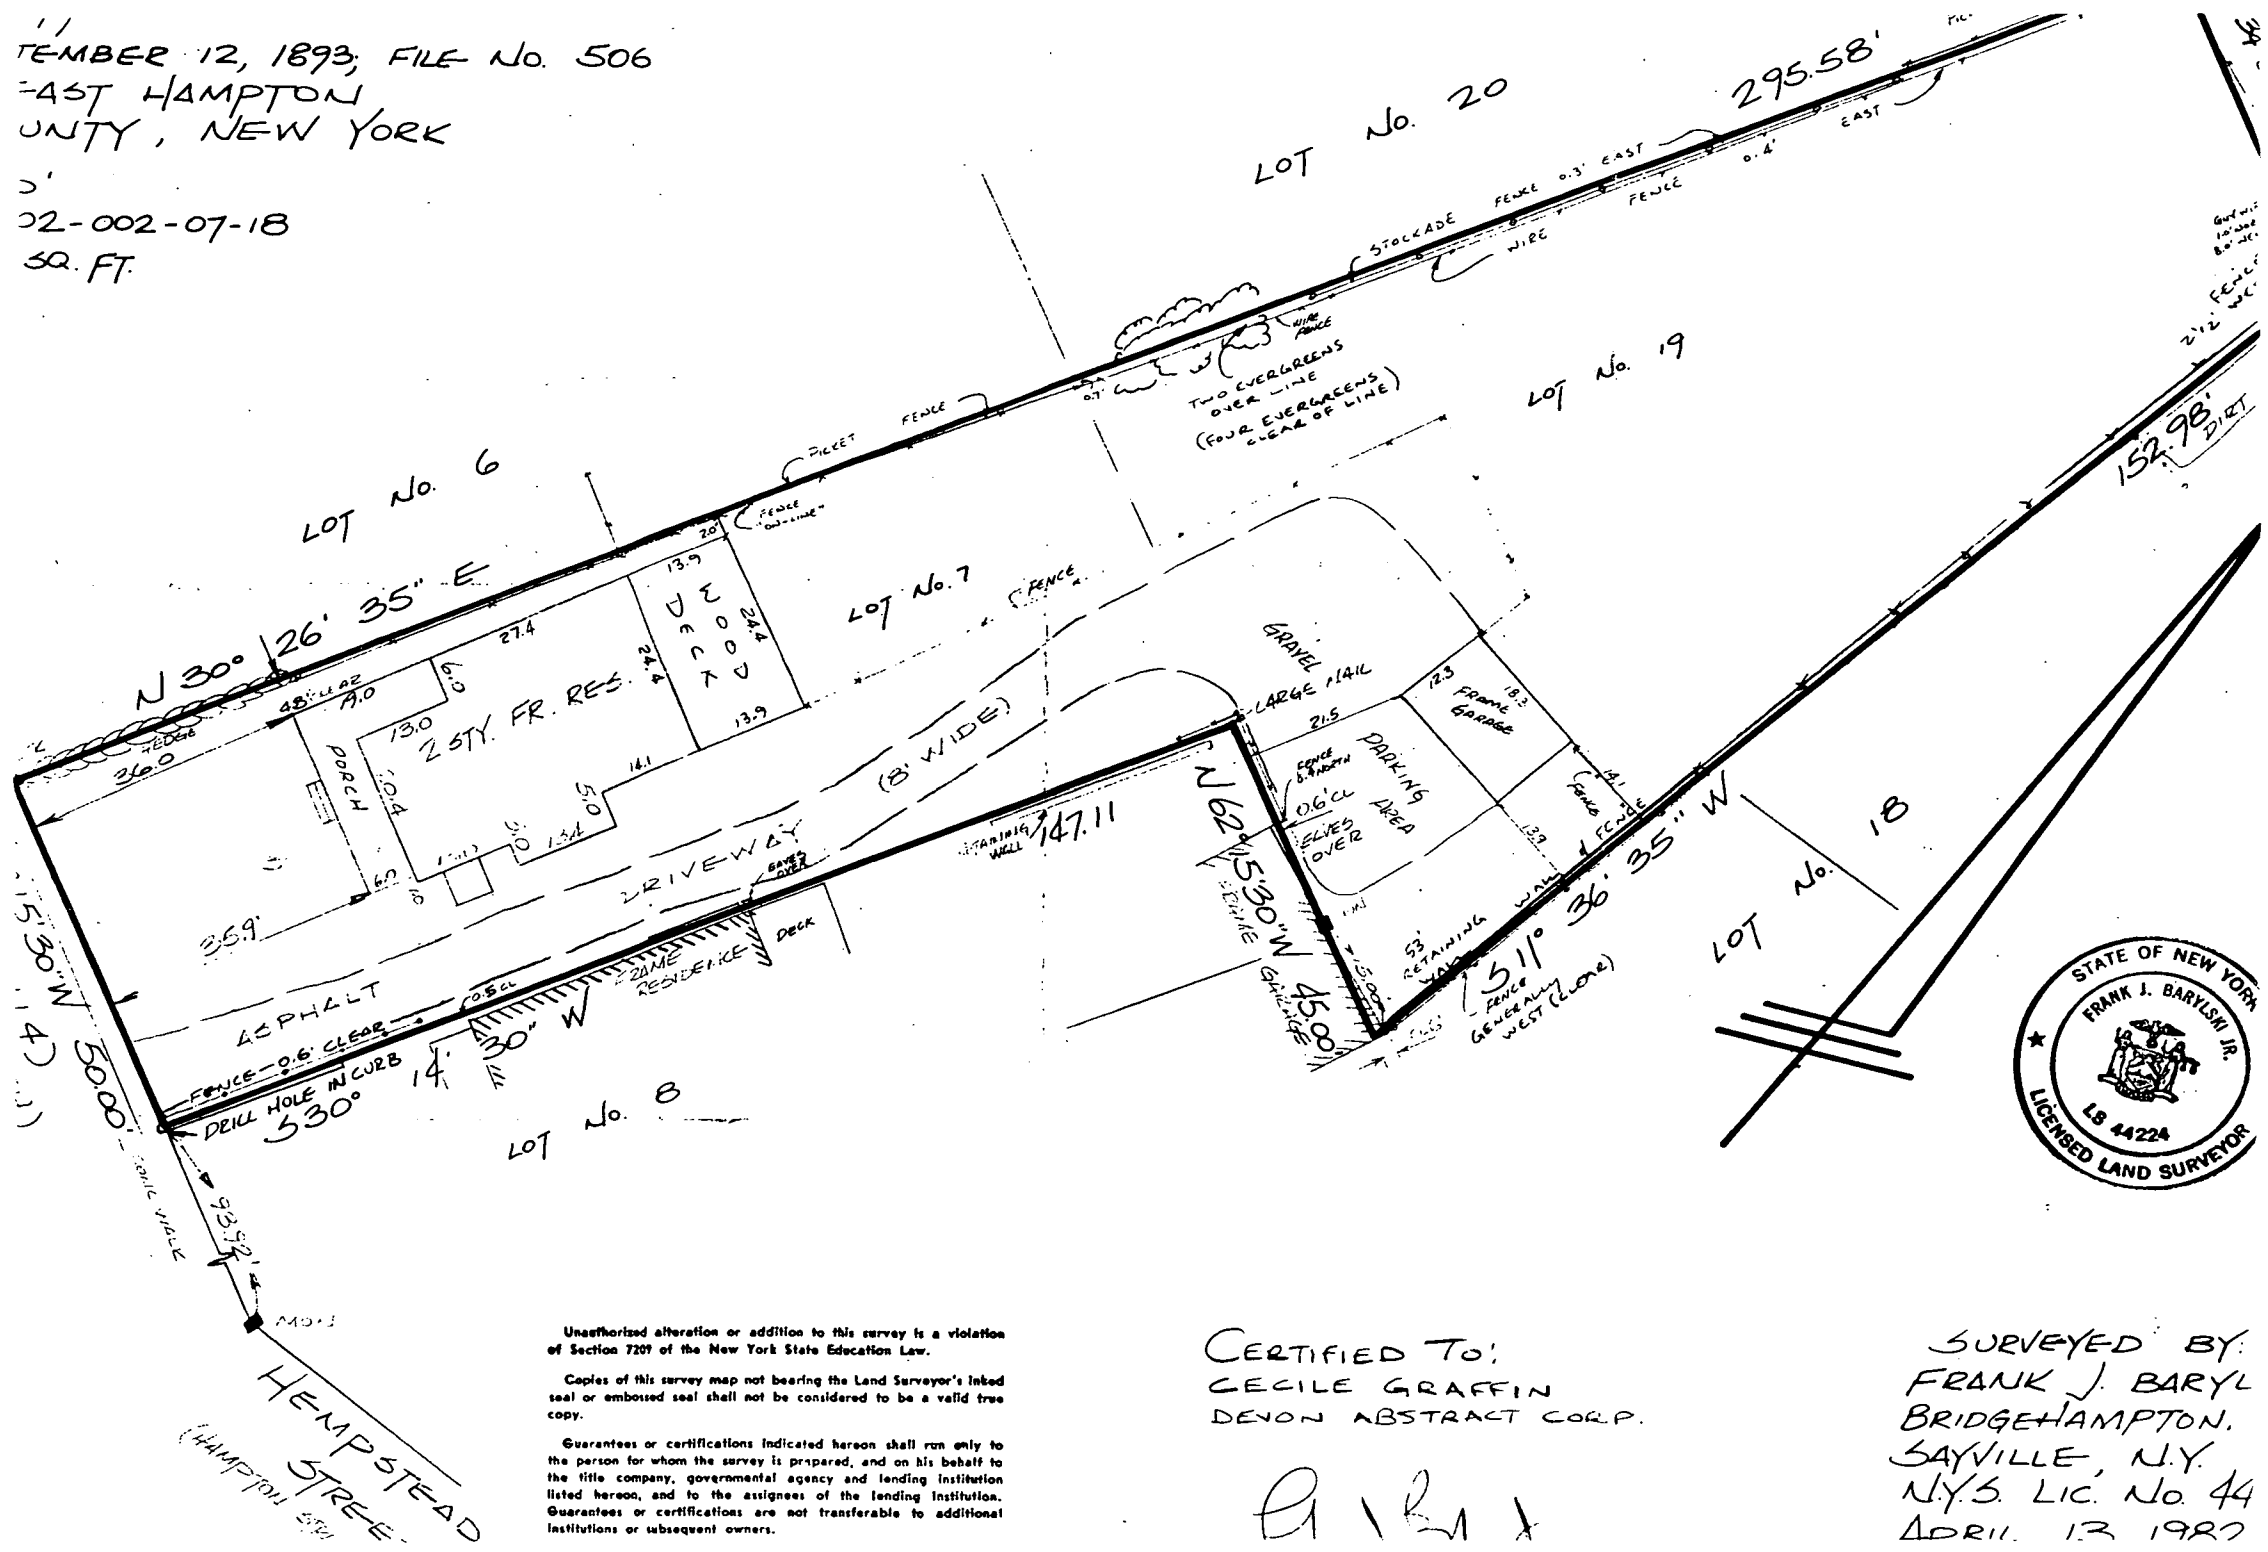

Unauthorized alteration or addition to this survey is a violation of Section 7207 of the New York State Education Law.

Copies of this survey map not bearing the Land Surveyor's Imbed seal or embossed seal shall not be considered to be a valid true copy.

Guarantees or certifications indicated hereon shall run only to the person for whom the survey is prepared, and on his behalf to the title company, governmental agency and lending institution listed hereon, and to the assignees of the lending institution. Guarantees or certifications are not transferable to additional institutions or subsequent owners.

CERTIFIED TO:
 CECILE GRAFFIN
 DEVON ABSTRACT CORP.

ARL

SURVEYED BY:
 FRANK J. BARYL
 BRIDGEHAMPTON,
 SAYVILLE, N.Y.
 N.Y.S. LIC. No. 44
 APRIL 13 1987