

UNAUTHORIZED ALTERATION OR ADDITION
TO THIS SURVEY IS A VIOLATION OF
SECTION 72-03 OF THE NEW YORK STATE
EVIDENCE LAW.
COPIES OF THIS SURVEY MAP NOT BEARING
THE LAND SURVEYOR'S GRASSHOPPER SEAL OR
WOODEN SEAL SHALL NOT BE CONSIDERED
TO BE A VALID TRUE COPY.
GUARANTEES INDICATED HEREON SHALL RUN
ONLY TO THE PERSON FOR WHOM THE SURVEY
WAS PREPARED, AND ON HIS BEHALF TO THE
TITLE COMPANY GOVERNMENTAL AGENCY AND
FINANCIAL INSTITUTION LISTED HEREON, AND
THE ASSIGNEES OF THE LANDMAN IN VITI-
TUTION. GUARANTEES ARE NOT TO BE OFFERED
TO ADDITIONAL INSTITUTIONS OR SUBSEQUENT
BUYERS.




SUFFOLK COUNTY TAX MAP
DISTRICT : 0904
SECTION : 02.00
BLOCK : 01.00
PARCEL : 028.001

CERTIFIED TO:
SOUTHOLD SAVINGS BANK
PRESIDENTIAL TITLE AGENCY

SURVEYED : DEC. 14, 1988 (SWIMMING POOL, DECK, FENCES)

Lester Holden
LESTER HOLDEN L.S. No. 49548
SQUIRES, HOLDEN, WEISENBACHER & SMITH
LAND SURVEYORS - ENGINEERS
SOUTHAMPTON - NEW YORK

MAP OF PROPERTY
FOR
SIMONE FELDMAN
SITUATE
INC. VILLAGE OF
SOUTHAMPTON
TOWN OF SOUTHAMPTON
SUFFOLK COUNTY, N.Y.
SCALE: 1" = 40'
AREA = 21,149 S.F. (0.486 AC.)

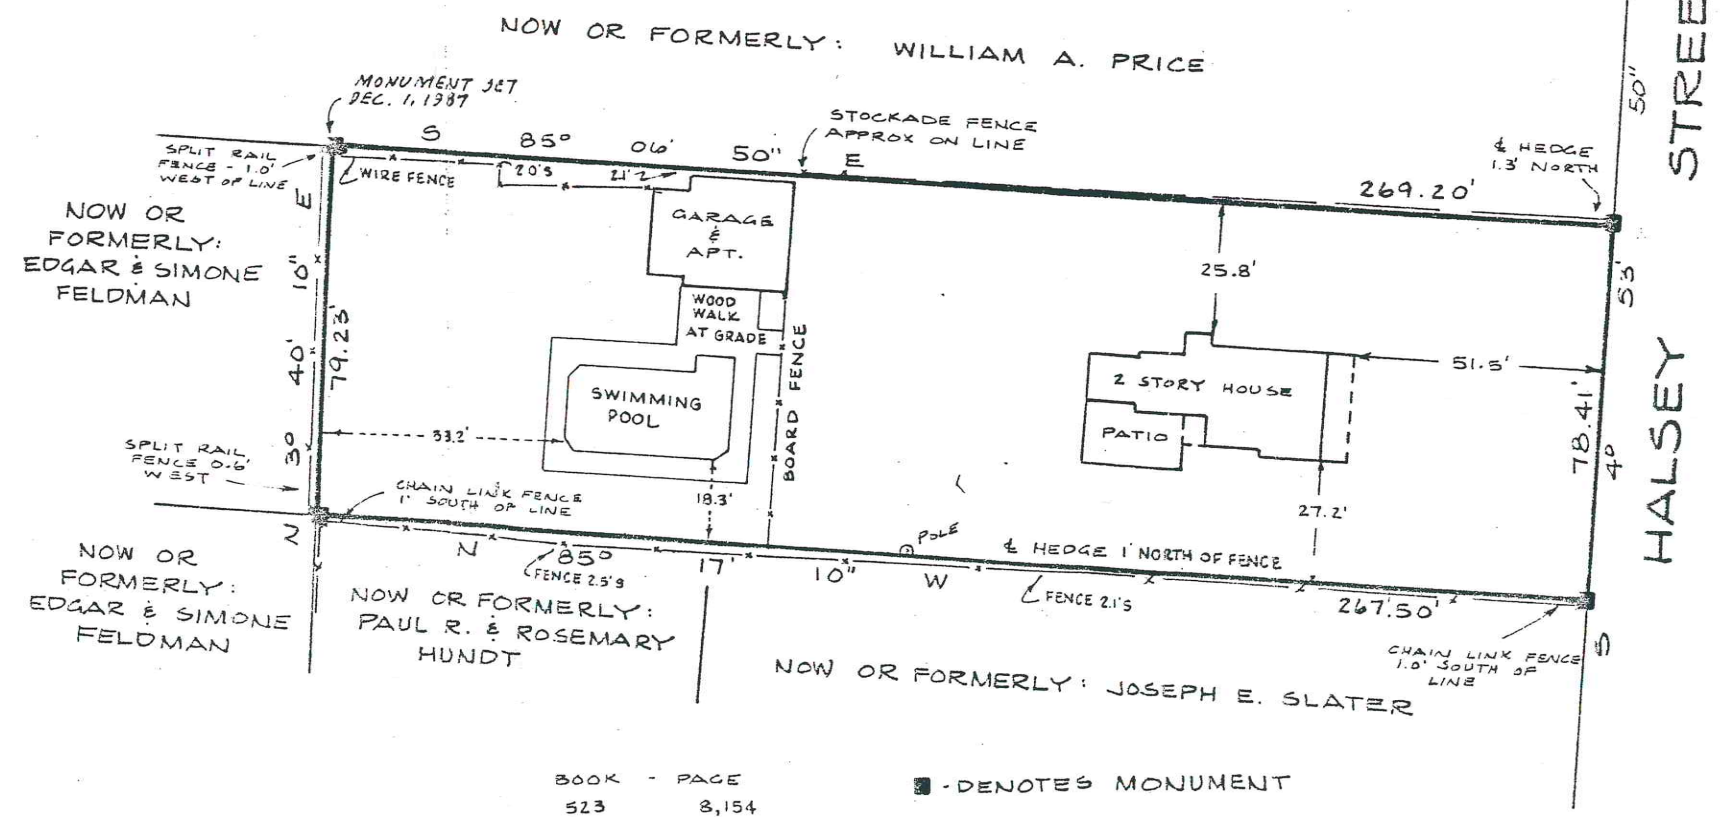

BOOK - PAGE
523 8,154
542 122
■ - DENOTES MONUMENT