

SCHD REF # - R03 - 04 - 0129
SCHD REF # - R03 - 12 - 0103

947-34
1115-108
1130-71

DC 13665

MAP OF PROPERTY
SECTION 1 WESLEY D. MILLER

Filed: DEC. 31, 1954 - Map No. 2296

SITUATE

FIREPLACE



Town Of East Hampton, Suffolk Co., N.Y.

Scale: 1"=30'

Area: 18,920 S.F. or 0.434 Acres

Certified To:

Basil Decastro

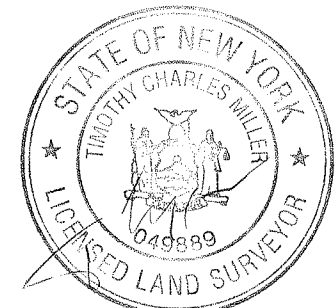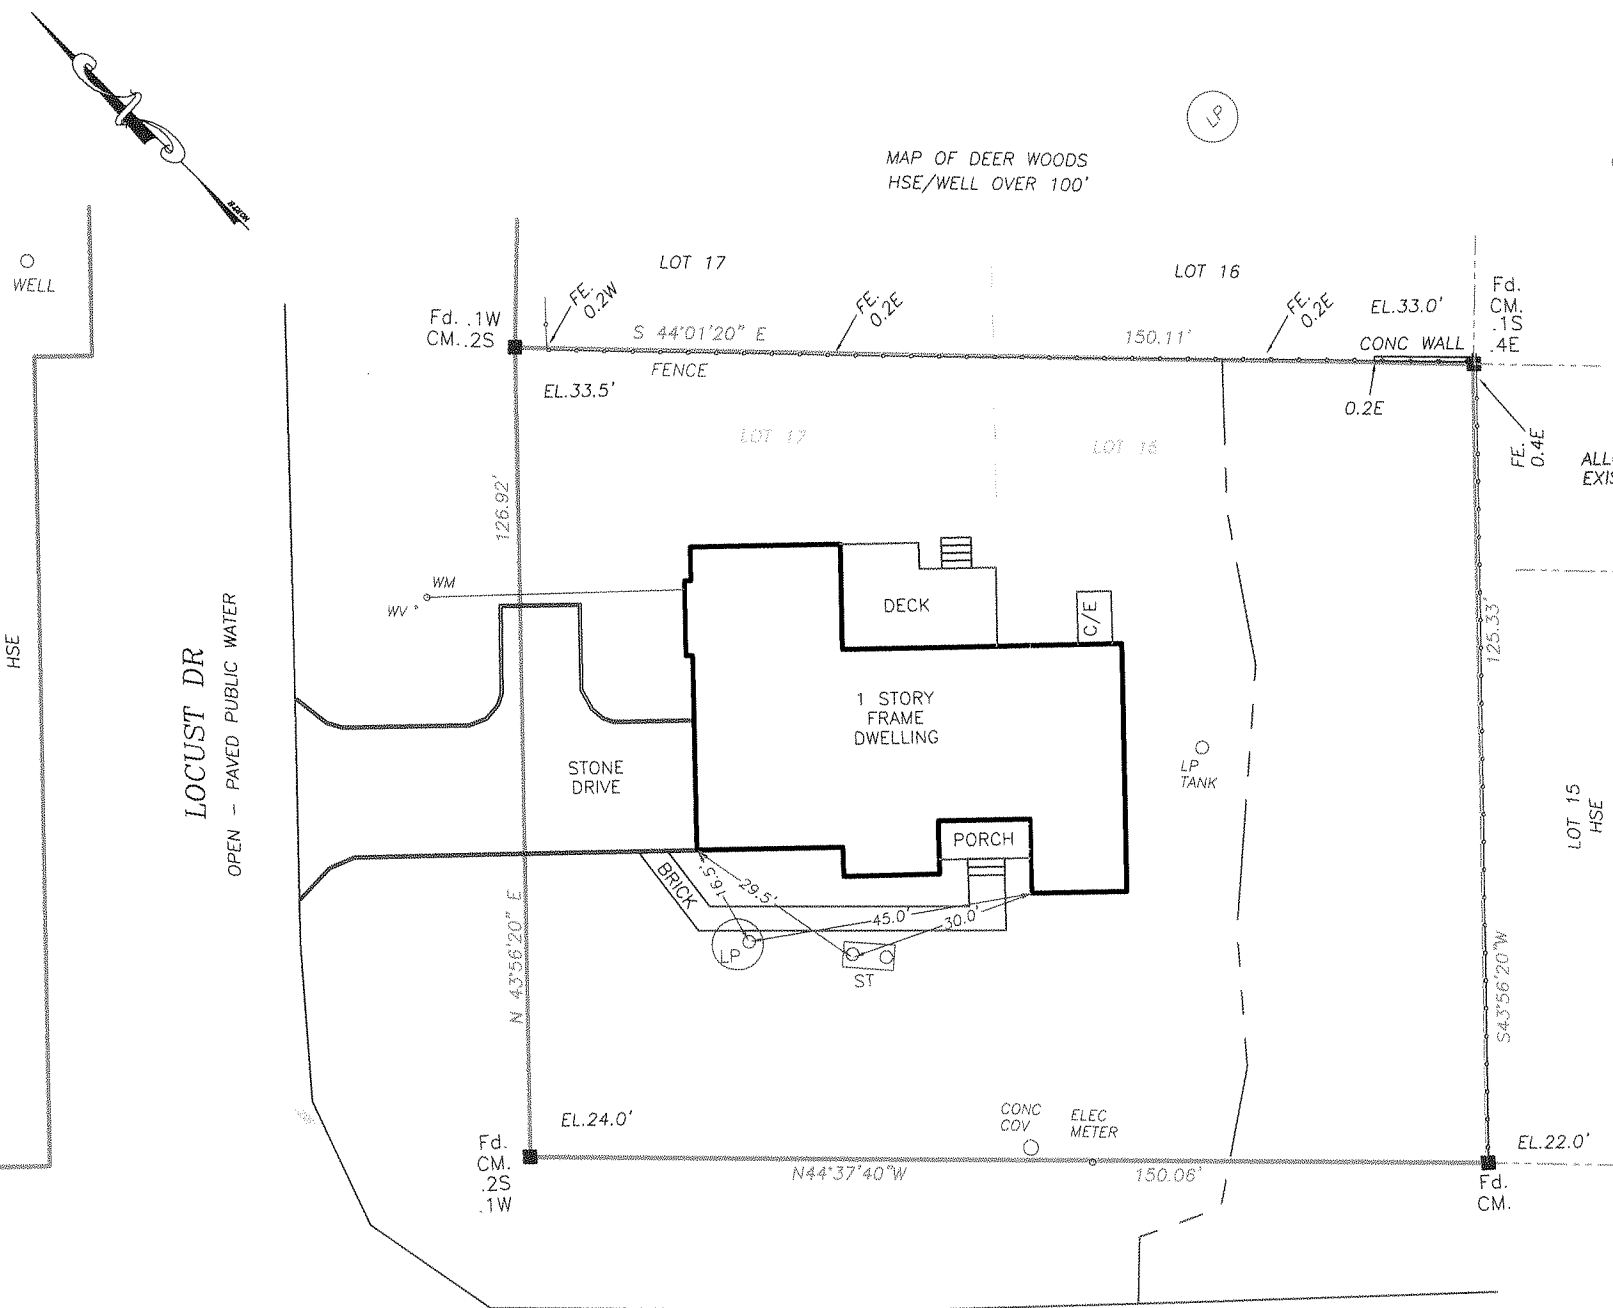

Revised: May 6, 2014 - Final
Revised: Nov. 9, 2012 - Stake Prop.
Revised: Aug. 27, 2012 - Proposed
Revised: December 1, 2006 - Note