
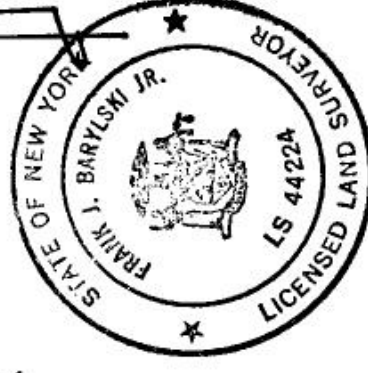


S.C.T.M. No. 900-113-01-4.14

SURVEYED FOR JAMES E. GRAND
PROPERTY LOCATED NORTH OF THE INC. VILLAGE OF SOUTHAMPTON
MAP OF SEVEN PONDS - SOUTHAMPTON
LOT No. 6

FILED: JANUARY 08, 1982, FILE No. 7043
TOWN OF SOUTHAMPTON
SUFFOLK COUNTY, NEW YORK
SCALE: 1"=40'
PLOT AREA = 30,001 SF

N

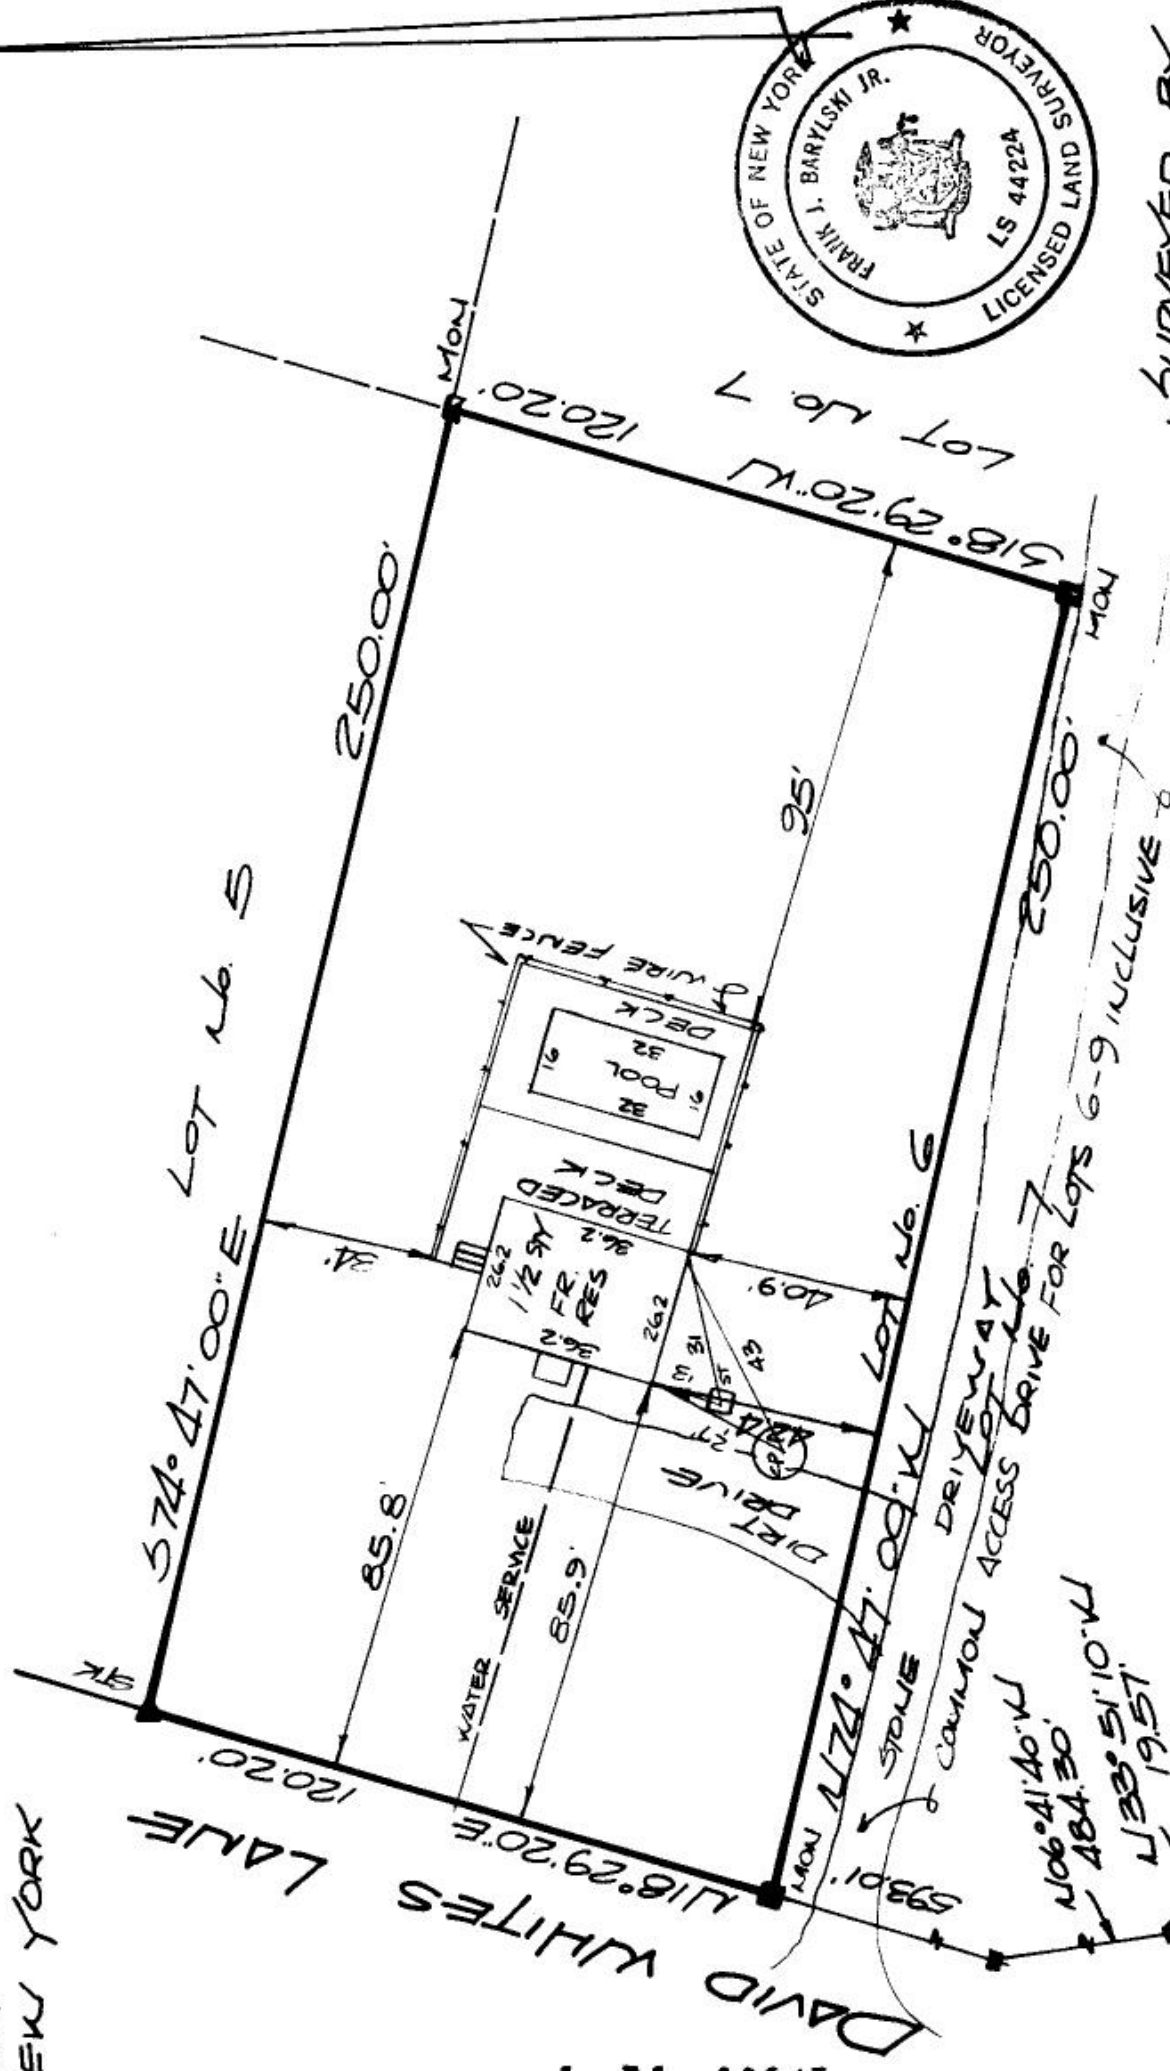

SURVEYED BY:
FRANK J. BARYLSKI
BRIDGEHAMPTON, NY
SAYVILLE, NY
NYS LIC. No. 44224
MAY 04, 1984

NOTE: WATER SERVICE, SEPTIC TANK AND
CESSPOOL LOCATION BY OTHERS.

FINAL SURVEY S-4-84

Unauthorized alteration or addition to this survey is a violation
of Section 7209 of the New York State Education Law.

Copies of this survey map not bearing the Land Surveyor's label
seal or embossed seal shall not be considered to be a valid true
copy.

Guarantees or certifications indicated hereon shall run only to
the person for whom the survey is prepared, and on his behalf to
the title company, governmental agency and lending institution
listed herein, and to the assignees of the lending institution.
Guarantees or certifications are not transferable to additional
institutions or subsequent owners.

GUARANTEED TO:
JAMES E. GRAND
THE TITLE GUARANTEE CO.
CITY BANK N.Y.C.

Frank J. Barylski

11239