
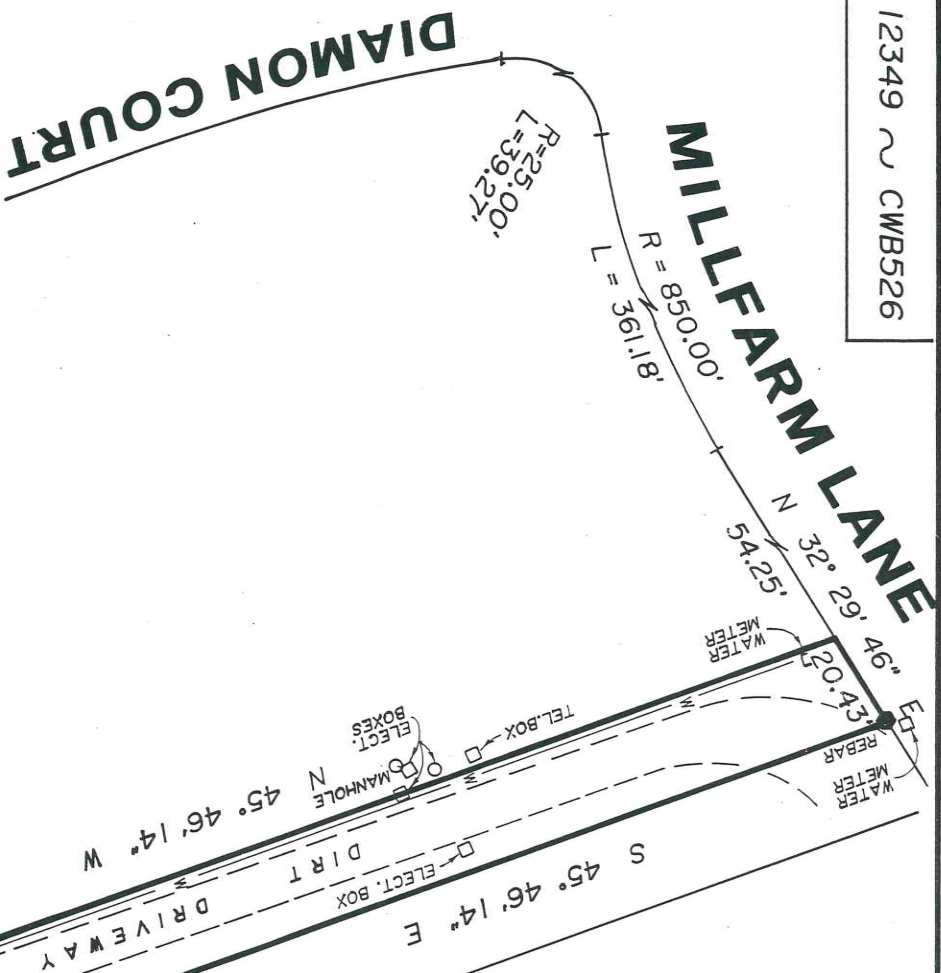



SUFFOLK COUNTY TAX MAP
DISTRICT 0900
SECTION 113.00
BLOCK 03.00
PARCEL 005.030

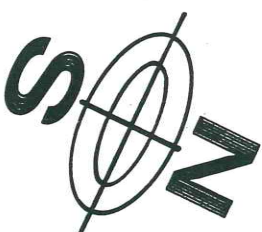

LOT 36

NOTE: WATER SERVICE LOCATION
AS PER OWNER.
SANITARY LOCATIONS AS
PER BUILDER.

NOTE: ENTIRE PARCEL PREVIOUSLY
CLEARED AS PER S.C.D.P.W.
TOPO MAPS OF FIVE EAST-
ERN TOWNS. MAP No. E-39
APPROVED, OCT. 3, 1975.

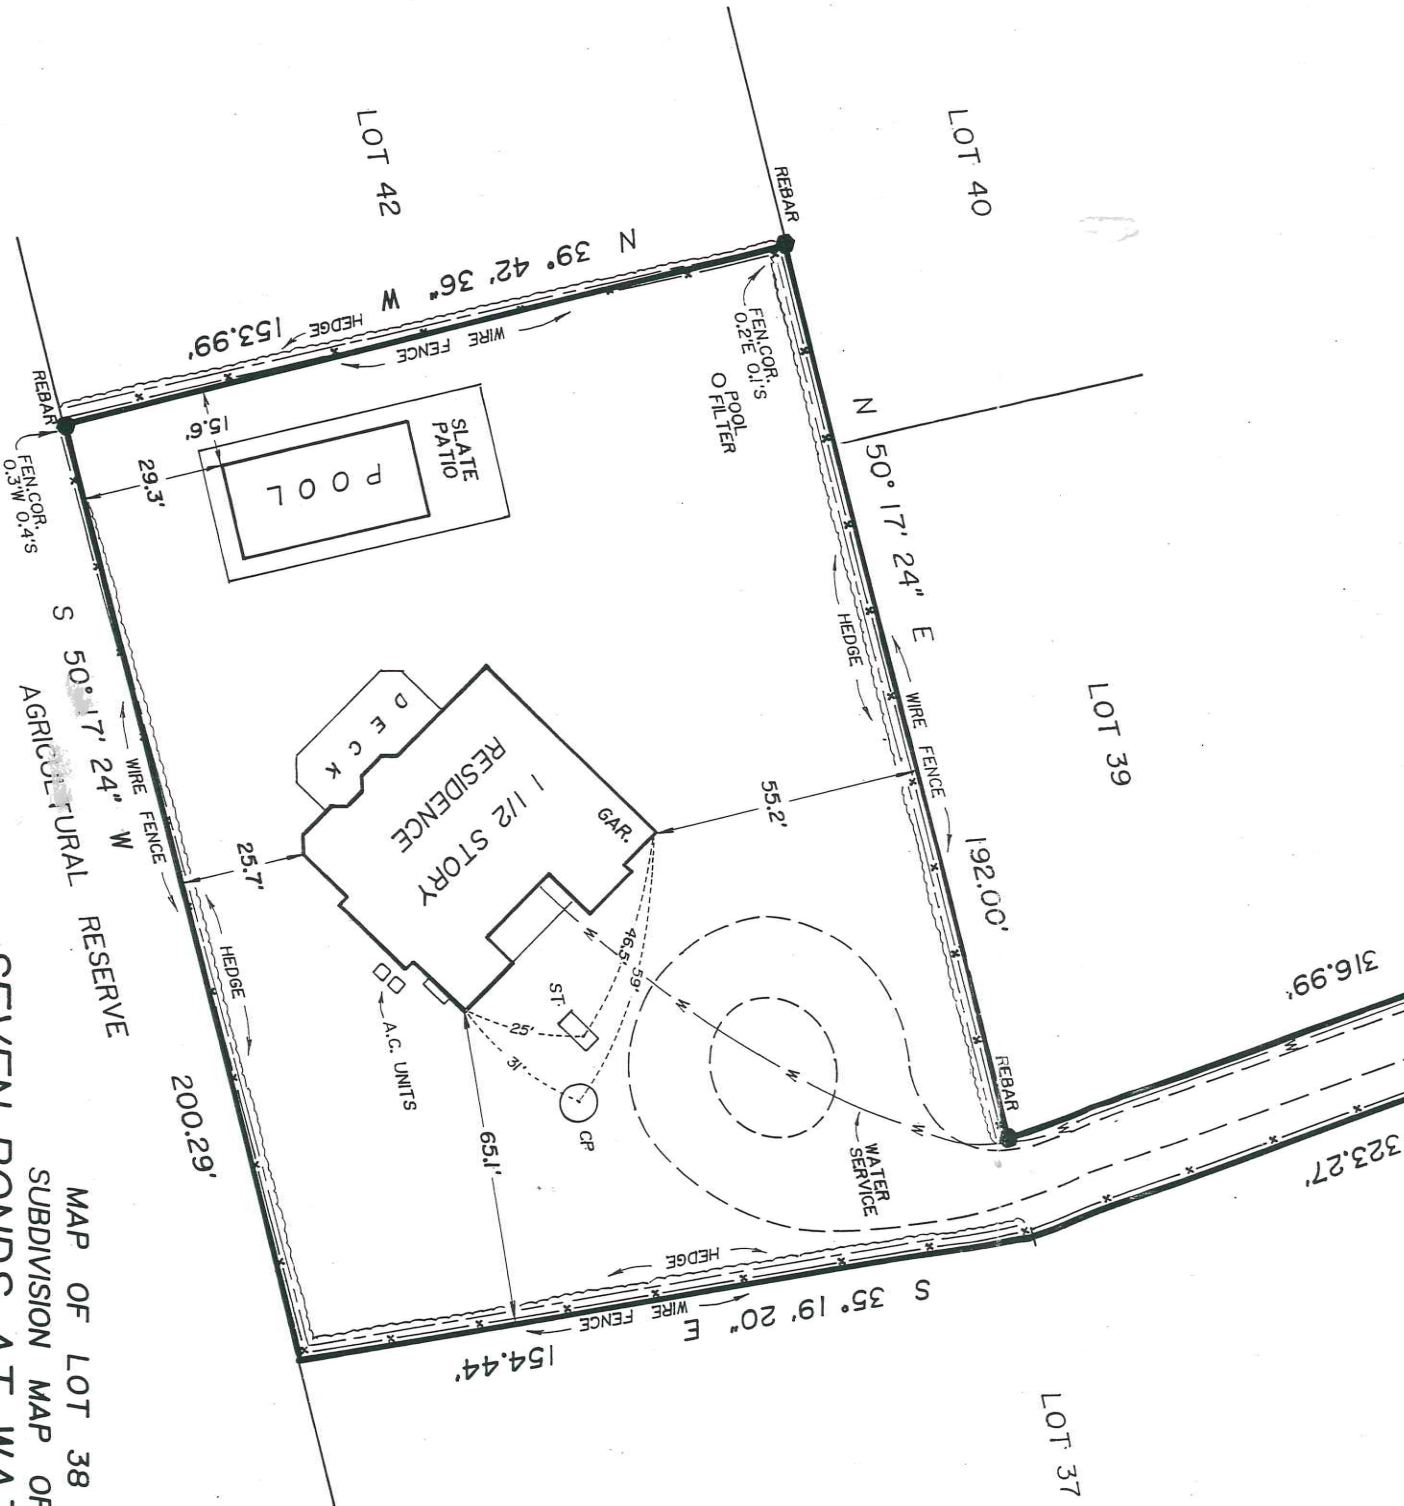

MAP OF LOT 38
SUBDIVISION MAP OF
SEVEN PONDS AT WATER MILL
FILED JAN. 27, 1988 FILE NO. 8467
SHEET 1 OF 2 SHEETS

FOR
FRANCIS J. & SUSAN KEENAN
SITUATE
WATER MILL
TOWN OF SOUTHAMPTON

S. H. W. & S., LAND SURVEYORS, P. C.
SQUIRES, HOLDEN, WEISENBACHER & SMITH
LAND SURVEYORS ~ ENGINEERS
SOUTHAMPTON ~ NEW YORK

SUFFOLK COUNTY, NEW YORK
SCALE 1" = 40'
AREA = 0.876 Acre
(38,153 Sq.Ft.)