




Job 1048
 20 Saddle Ln.
 EH

Storm Watch
 White Int.

SHAWN F. LEONARD, ARCHITECT
 320 HAMPTON ROAD
 SOUTHAMPTON, NEW YORK 11968
 TEL: (631) 287-5557, FAX: (631) 287-5558

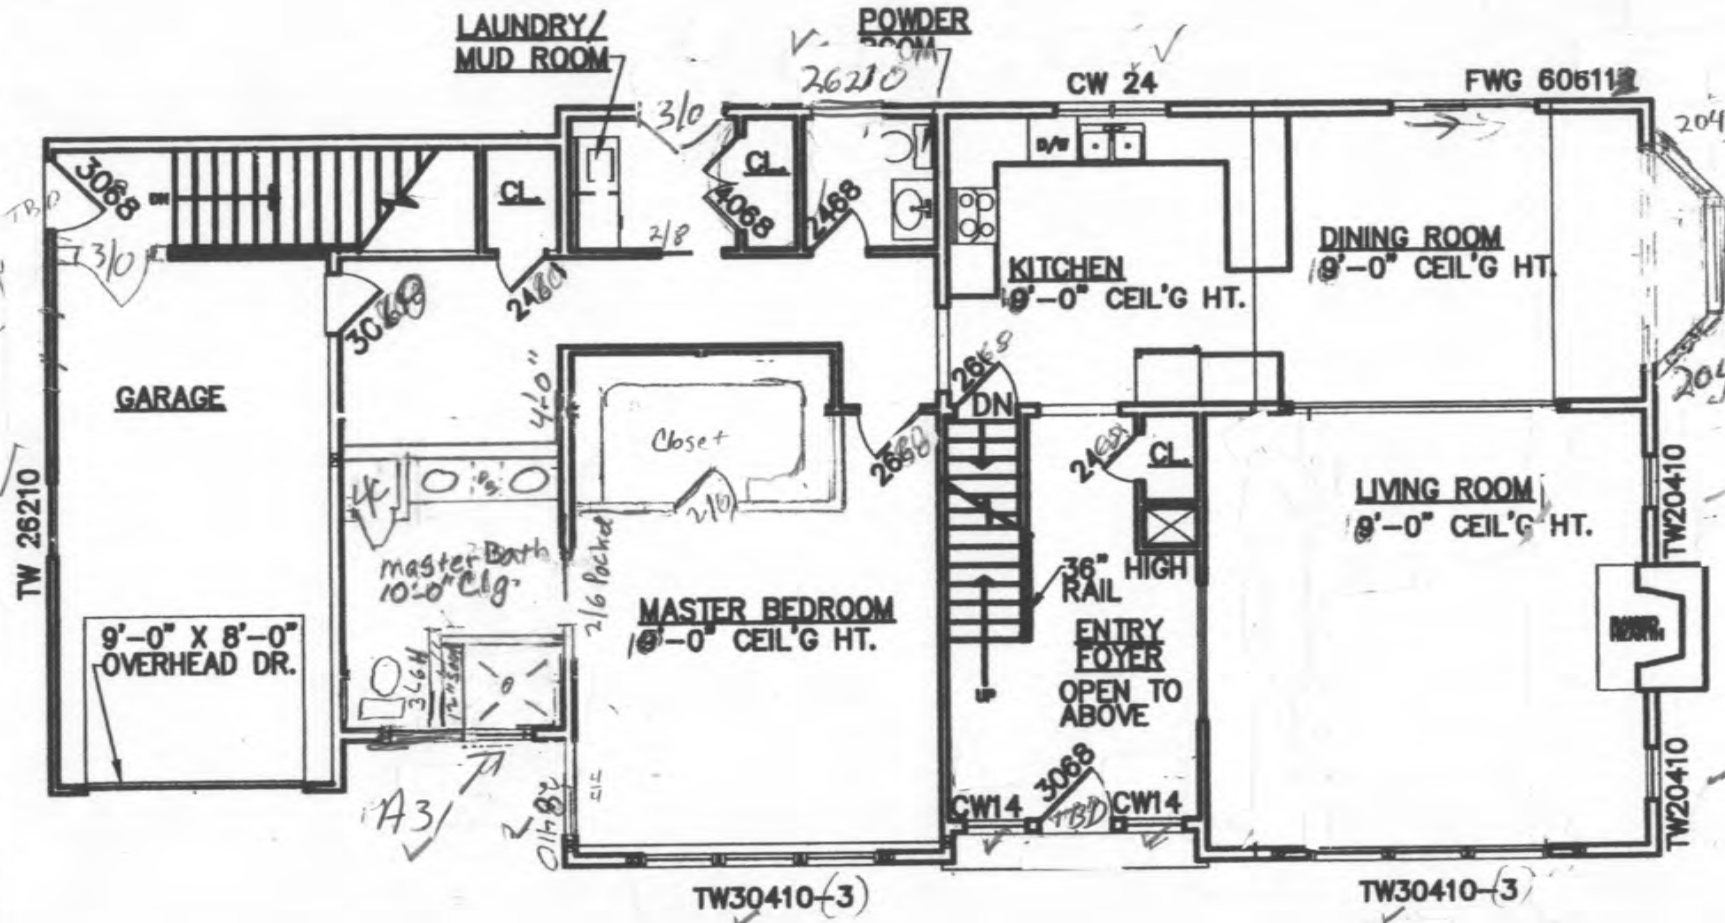

NEW SUNSHINE
 COTTAGE
 FIRST FLOOR PLAN

COTTAGE FIRST FLOOR PLAN

SCALE: 1/8" = 1'-0"
 FIRST FLOOR AREA = 1854 SQ FT 1580
 GARAGE AREA = 264 SQ FT

DRAWN BY	RAS
CHECKED BY	SFL
SCALE	1/8" = 1'-0"
DATE	12.01.10
PROJECT	SK-2

