


LOT AREA: 17,738 SQ. FT.  
(WOW/TLD.) OR 0.41 ACRE

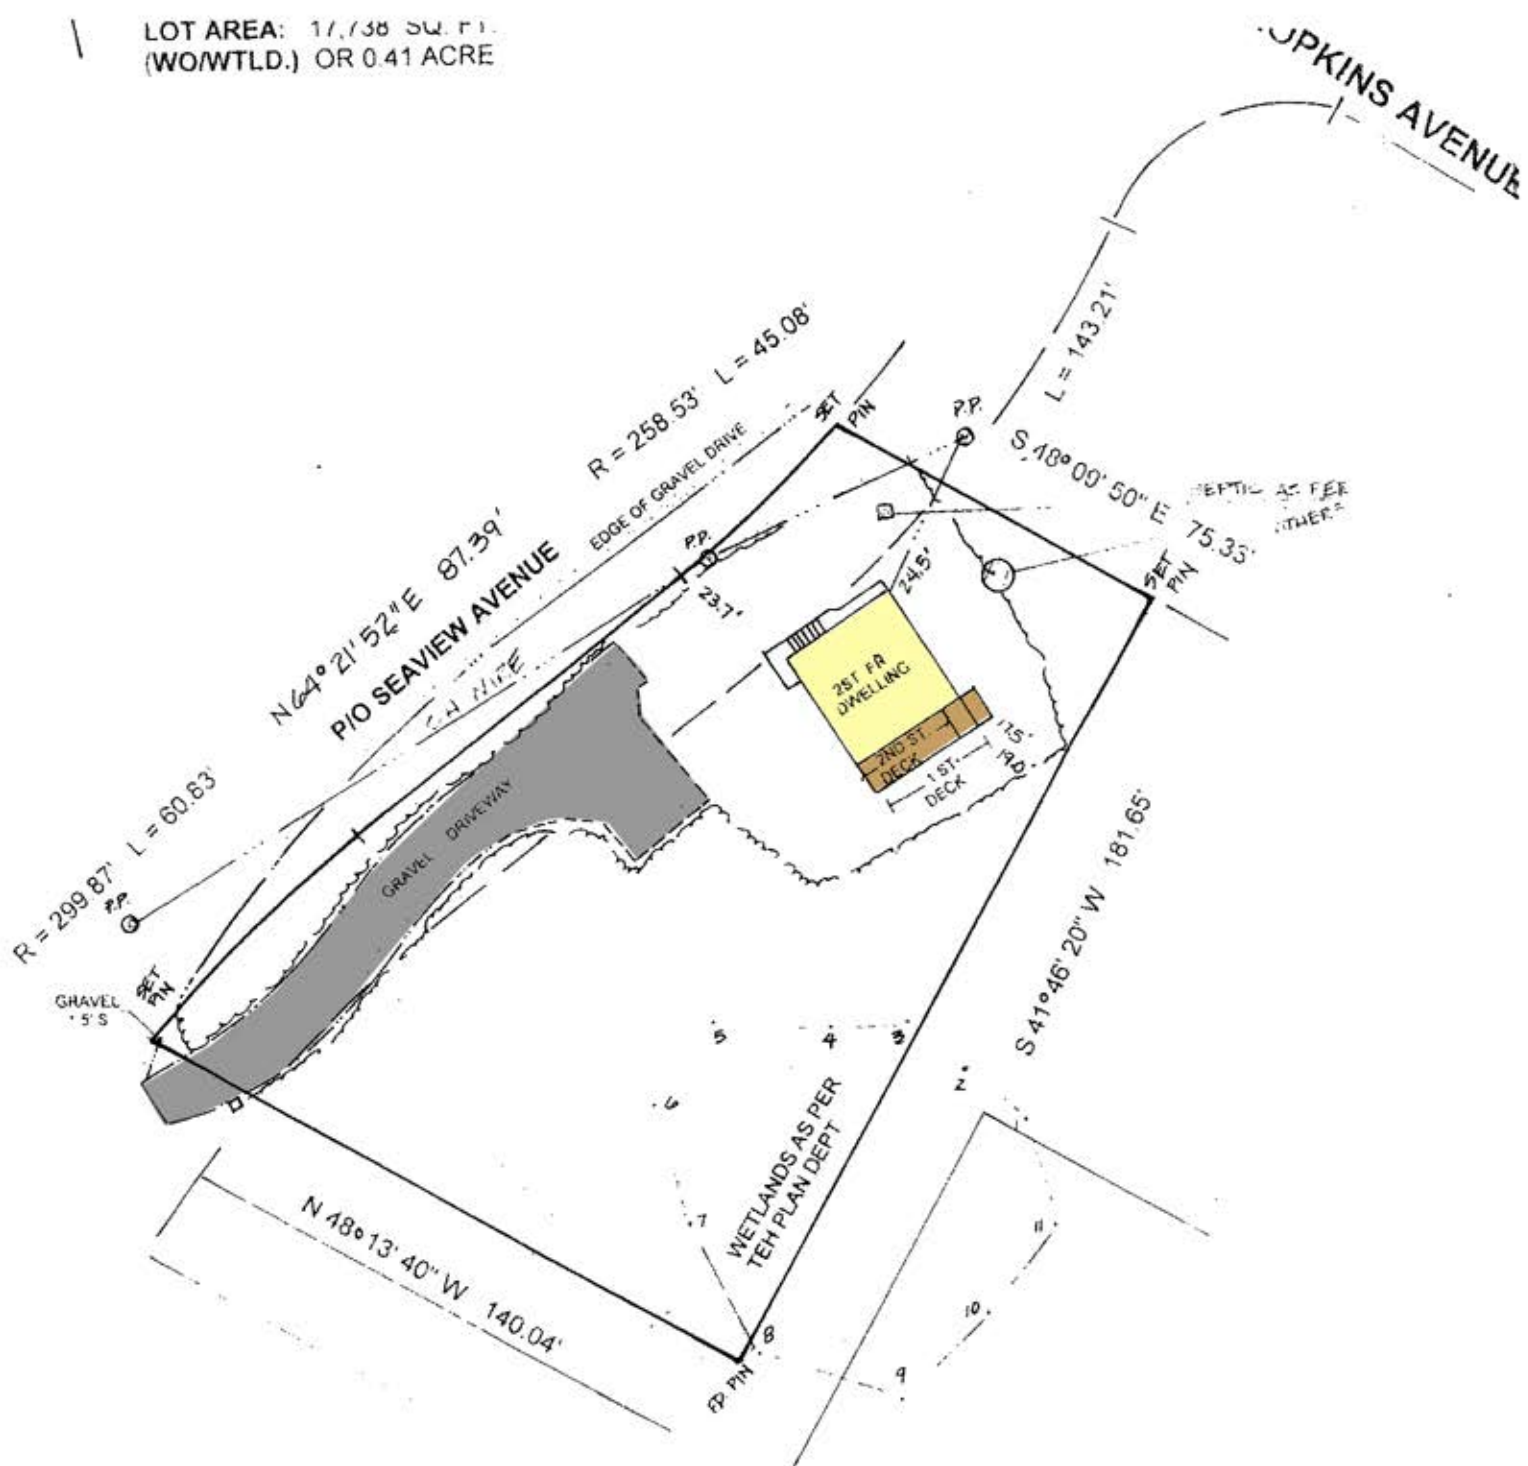

SURVEYED MARCH 6, 2012  
WILLIAM J. WALSH,  
LAND SURVEYOR  
MONTAUK, N.Y.

*William J. Walsh*



EASEMENTS, RIGHT OF WAYS  
UNDERGROUND UTILITIES AND OR  
SANITARY FACILITIES NOT VISIBLE  
AT THE TIME OF SURVEY HAVE NOT  
BEEN SHOWN, LOCATED AND/OR  
GUARANTEED

GUARANTEES OR CERTIFICATIONS INDICATED ON  
HALL RUN ONLY TO THE PERSON OR WHO THE SURVEY  
IS PREPARED, & ON HIS BEHALF TO THE TITLE  
COMPANY GOVERNMENTAL AGENCY & LENDING  
INSTITUTIONS LISTED HEREON, & TO THE ASSIGNEES  
OF THE LENDING INSTITUTION GUARANTEES OR