

5433 A2177

F15996


SUFFOLK COUNTY TAX MAP  
DISTRICT ; 0900  
SECTION ; 030.00  
BLOCK ; 01.00  
PARCEL ; 018.000

TOTAL AREA OF HOUSE  
DECKS & SHED = 3672 IP  
WHICH EQUALS 79%  
OF LOT AREA

TOTAL AREA OF HOUSE  
DECK, SHED & REDUCED  
GARAGE = 4248 IP WHICH  
EQUALS 89% OF LOT AREA

STATE OF NEW YORK  
SUFFOLK COUNTY  
OFFICE OF THE SURVEYOR  
SOUTHAMPTON  
I HEREBY CERTIFY THAT THE  
FOREGOING IS A TRUE AND  
CORRECT COPY OF THE  
ORIGINAL RECORD AS FILED  
IN MY OFFICE ON THIS  
DATE.

SURVEYED AND PLATTED 23 1969  
ROBERT A. SMITH  
PROFESSIONAL LAND SURVEYOR  
NO. 49239  
SQUIRE, GOLDEN, WEISENBACHER & SMITH  
LAND SURVEYORS & ENGINEERS, SOUTHAMPTON, N.Y.

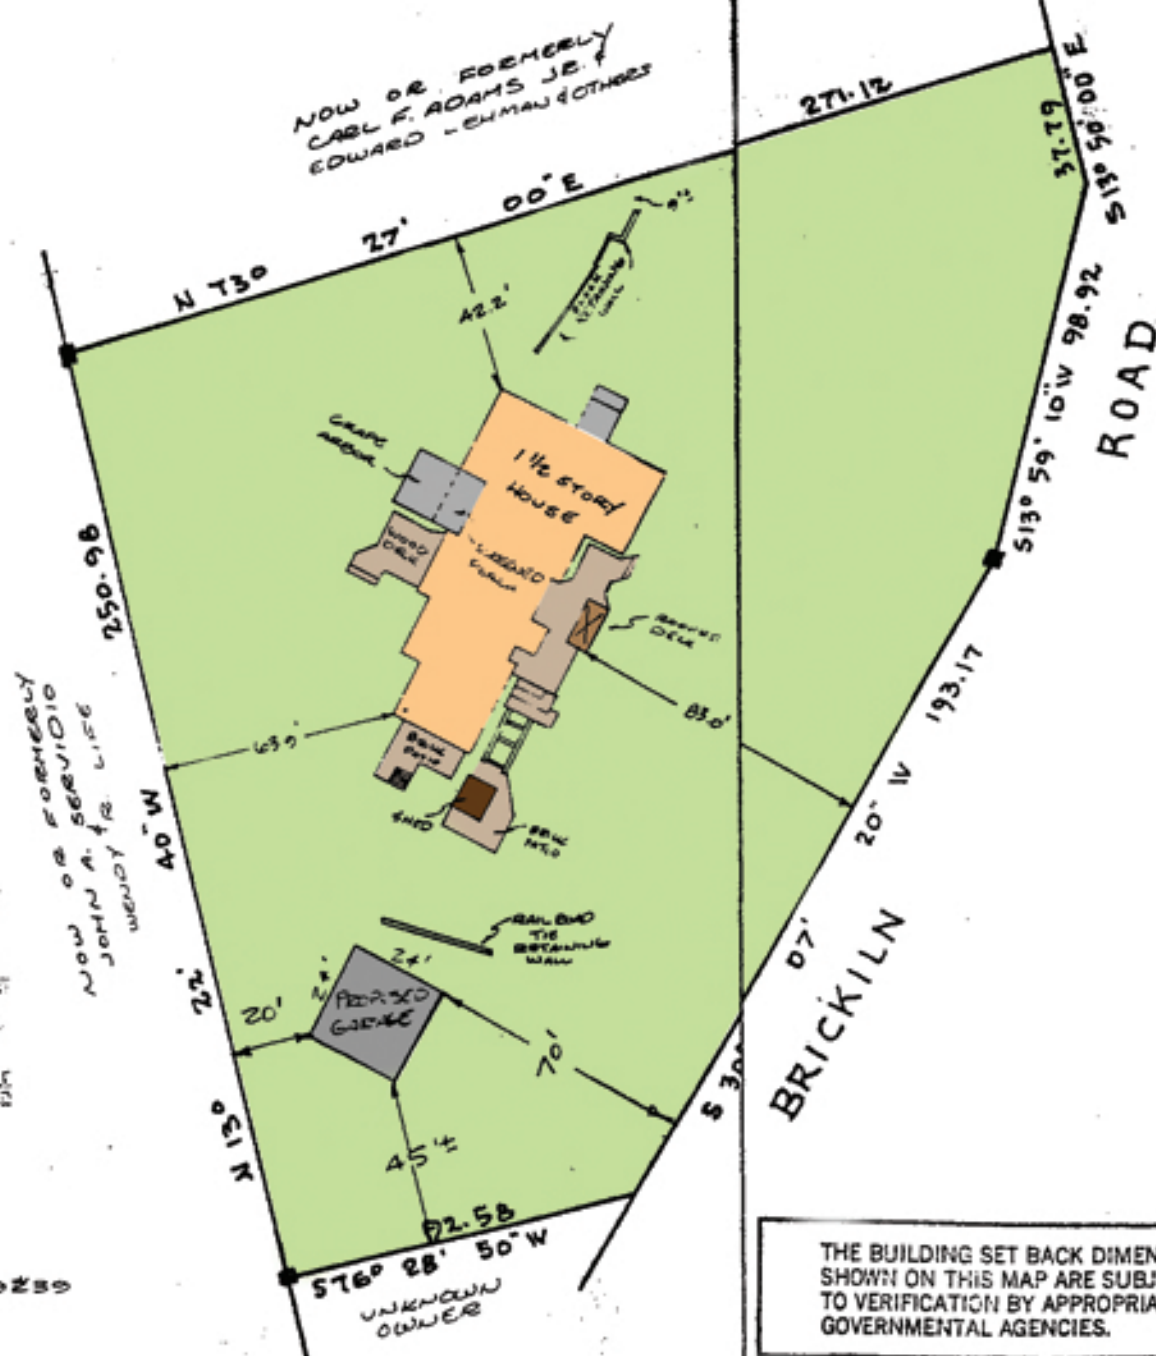

BRIDGEHAMPTON  
TOWN OF SOUTHAMPTON  
SUFFOLK COUNTY, N.Y.

AREA = 1.201 ACRES  
(52312 SQ. FT.)

SCALE: 1" = 50'  
■ DENOTES MON.

THE BUILDING SET BACK DIMENSIONS  
SHOWN ON THIS MAP ARE SUBJECT  
TO VERIFICATION BY APPROPRIATE  
GOVERNMENTAL AGENCIES.

586 944 BOOK NO. 267  
187, 08 95 PAGE NO. 64, 70  
CHECKED