
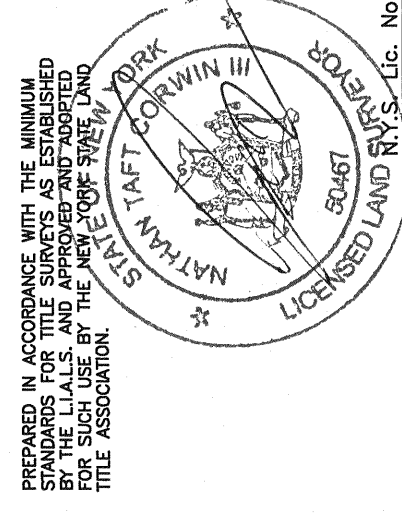


SURVEY OF PROPERTY
SITUATED AT
WATER MILL
TOWN OF SOUTHAMPTON
SUFFOLK COUNTY, NEW YORK
S.C. TAX No. 900-64-03-6.7

SCALE 1"=50'

SEPTEMBER 25, 1997
OCTOBER 23, 1997 UPDATED PLOT PLAN
JANUARY 21, 1998 FOUNDATION LOCATION
SEPTEMBER 28, 1998 FINAL SURVEY
AUGUST 20, 2013 STAKE PROPERTY LINE
S.C.D.H.S. No. R09-97-0476
AREA = 200,086.12 sq. ft.
4.5933 ac.

NOTE:
THIS PROPERTY IS ALSO KNOWN AS PARCEL ONE ON
MAP OF MINOR SUBDIVISION OF MAP OF WATER MILL HEIGHTS

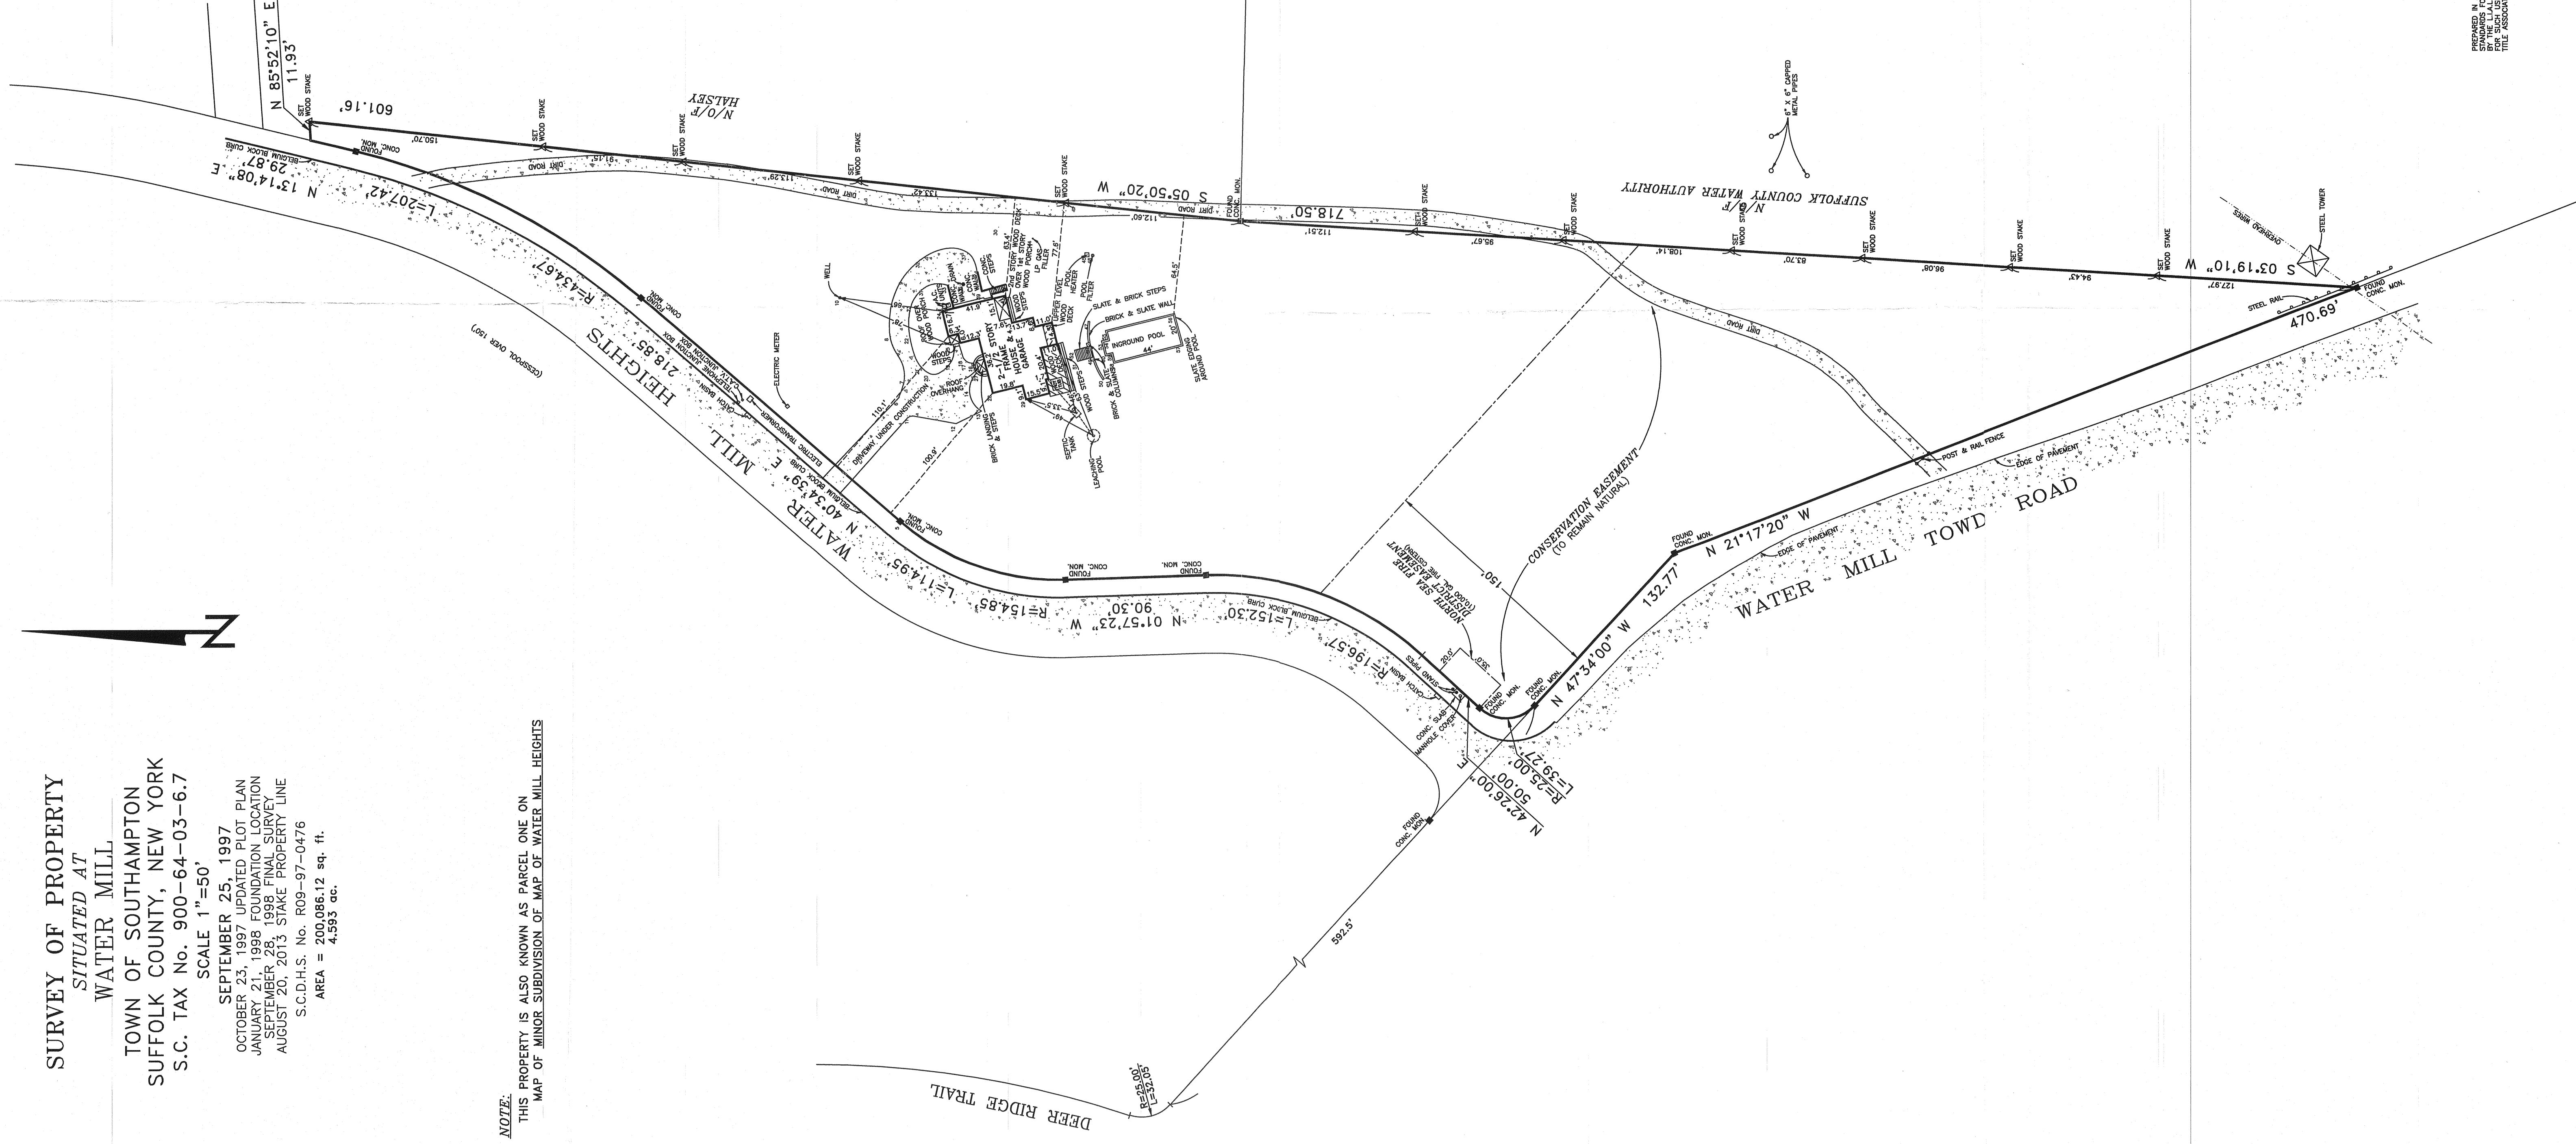

Nathan Taft Corwin III
Land Surveyor

Successor To: Stanley J. Jackson, Jr. L.S.
Joseph A. Ingogno L.S.
Title Surveys - Subdivisions - Site Plans - Construction Layout
PHONE (631) 727-2090 Fax (631) 727-1727
OFFICES LOCATED AT MAILING ADDRESS
1586 Main Road P.O. Box 16
Jamestown, New York 11947

UNAUTHORIZED ALTERATION OR ADDITION
TO THIS SURVEY MAP IS PROHIBITED.
SECTION 2009 OF THE NEW YORK STATE
SURVEYS AND MAPPING LAW.
COPIES OF THIS SURVEY MAP NOT BEARING
THE LAND SURVEYOR'S INKED SEAL OR
SIGNATURE SHALL BE CONSIDERED
TO BE A FALSE COPY.
CERTIFICATIONS INDICATED HEREON SHALL REMAIN
IN FULL FORCE AND EFFECT UNTIL THE NEXT
IS PREPARED, AND ON THE BEHALF OF THE SURVEYOR
AND HIS SUCCESSORS, THE SURVEYOR AND
LAND SURVEYING INSTITUTION LISTED HEREON, AND
ANY PERSONS WHOSE NAMES ARE LISTED HEREON,
THESE CERTIFICATIONS ARE NOT TRANSFERABLE.

THE EXISTENCE OF RIGHT OF WAYS
AND/OR EASEMENTS OF RECORD, IF
ANY, NOT SHOWN ARE NOT GUARANTEED.