


EO NEW YORK

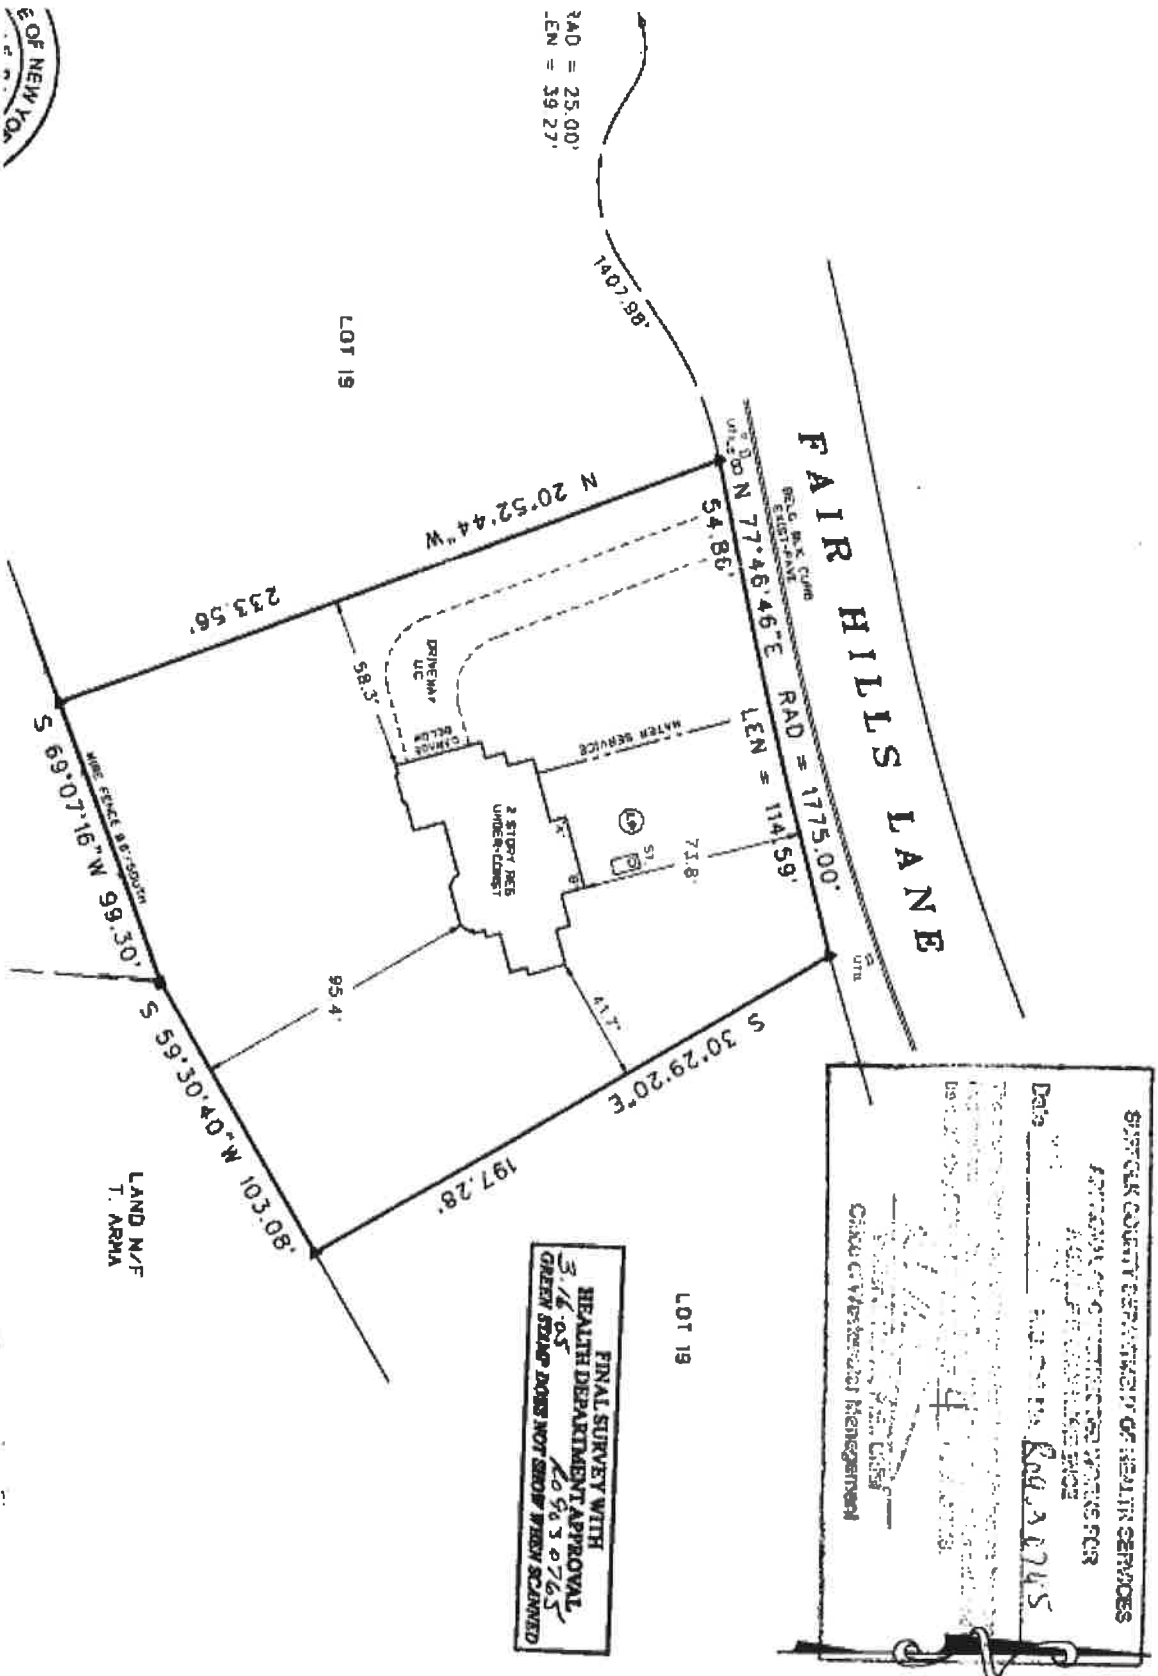

SOUTHERN COUNTY DEPARTMENT OF HEALTH SERVICES
PERMIT TO CONSTRUCT WORKS FOR
WATER SERVICE
DATE 04/22/05
BY [Signature]
CHIEF OF WATERWORKS MANAGEMENT