


SURVEY of PROPERTY

SITUATE
NOYACK
TOWN OF SOUTHAMPTON
SUFFOLK COUNTY, N.Y.

SURVEYED, JUNE 12, 2013

Rosewood Drive (50')

Stony Hill Drive (50')

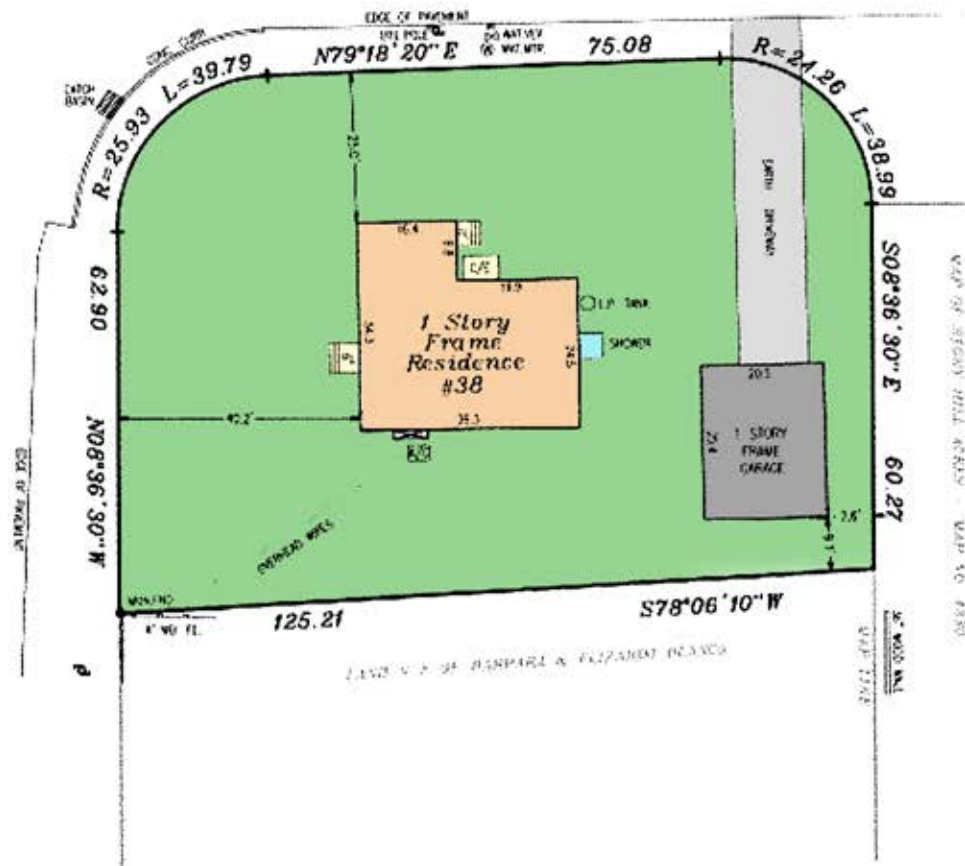

NOTES

1. PROPERTY KNOWN AS TAX MAP# 0900-018-01-061
2. LOT AREA = 10,387.47 SQ FT (0.243 ACRES)
3. THIS SURVEY WAS PREPARED USING A TRIMBLE 53 ROBINO TOTAL STATION
4. PROPERTY CORNER MEASUREMENTS WERE NOT SET AS PART OF THIS SURVEY.

STANDARD NOTES

1. THIS SURVEY WAS MADE BY MEASURING THE DISTANCES AND ANGLES OF THE BOUNDARIES OF THE PROPERTY AND THE DISTANCES AND ANGLES OF THE INTERIORS OF THE PROPERTY.
2. THE DISTANCES AND ANGLES OF THE BOUNDARIES OF THE PROPERTY WERE MEASURED BY MEANS OF A TRIMBLE 53 ROBINO TOTAL STATION.
3. THE DISTANCES AND ANGLES OF THE INTERIORS OF THE PROPERTY WERE MEASURED BY MEANS OF A TRIMBLE 53 ROBINO TOTAL STATION.
4. THE DISTANCES AND ANGLES OF THE BOUNDARIES OF THE PROPERTY WERE MEASURED BY MEANS OF A TRIMBLE 53 ROBINO TOTAL STATION.
5. THE DISTANCES AND ANGLES OF THE INTERIORS OF THE PROPERTY WERE MEASURED BY MEANS OF A TRIMBLE 53 ROBINO TOTAL STATION.
6. THE DISTANCES AND ANGLES OF THE BOUNDARIES OF THE PROPERTY WERE MEASURED BY MEANS OF A TRIMBLE 53 ROBINO TOTAL STATION.
7. THE DISTANCES AND ANGLES OF THE INTERIORS OF THE PROPERTY WERE MEASURED BY MEANS OF A TRIMBLE 53 ROBINO TOTAL STATION.
8. THE DISTANCES AND ANGLES OF THE BOUNDARIES OF THE PROPERTY WERE MEASURED BY MEANS OF A TRIMBLE 53 ROBINO TOTAL STATION.
9. THE DISTANCES AND ANGLES OF THE INTERIORS OF THE PROPERTY WERE MEASURED BY MEANS OF A TRIMBLE 53 ROBINO TOTAL STATION.
10. THE DISTANCES AND ANGLES OF THE BOUNDARIES OF THE PROPERTY WERE MEASURED BY MEANS OF A TRIMBLE 53 ROBINO TOTAL STATION.

THIS SURVEY WAS MADE BY MEASURING THE DISTANCES AND ANGLES OF THE BOUNDARIES OF THE PROPERTY AND THE DISTANCES AND ANGLES OF THE INTERIORS OF THE PROPERTY.



MICHAEL K. WICKS, PLS #50390

MICHAEL K. WICKS
LAND SURVEYING

200 BELLE VIEW AVENUE
CENTER MORICHES, NEW YORK 11934
VOICE: 631.874.0156 - FAX: 631.909.3045

SCALE:	SURVEYED BY:	DRAWN BY:	SHEET:
1"=20'	A.C./B.W.	A.C.	1 OF 1