


SURVEYED FOR CHARLES WEIGELL
 PROPERTY LOCATED AT FIREPLACE
 MAP OF CLEARWATER BEACH, SECTION No. 3
 Lot No. 715
 FILED: FEB. 25, 1960; FILE No. 3122
 TOWN OF EAST HAMPTON
 SUFFOLK COUNTY, NEW YORK
 SCALE: 1" = 30'

S.C.T.M. No 500-039-9-14

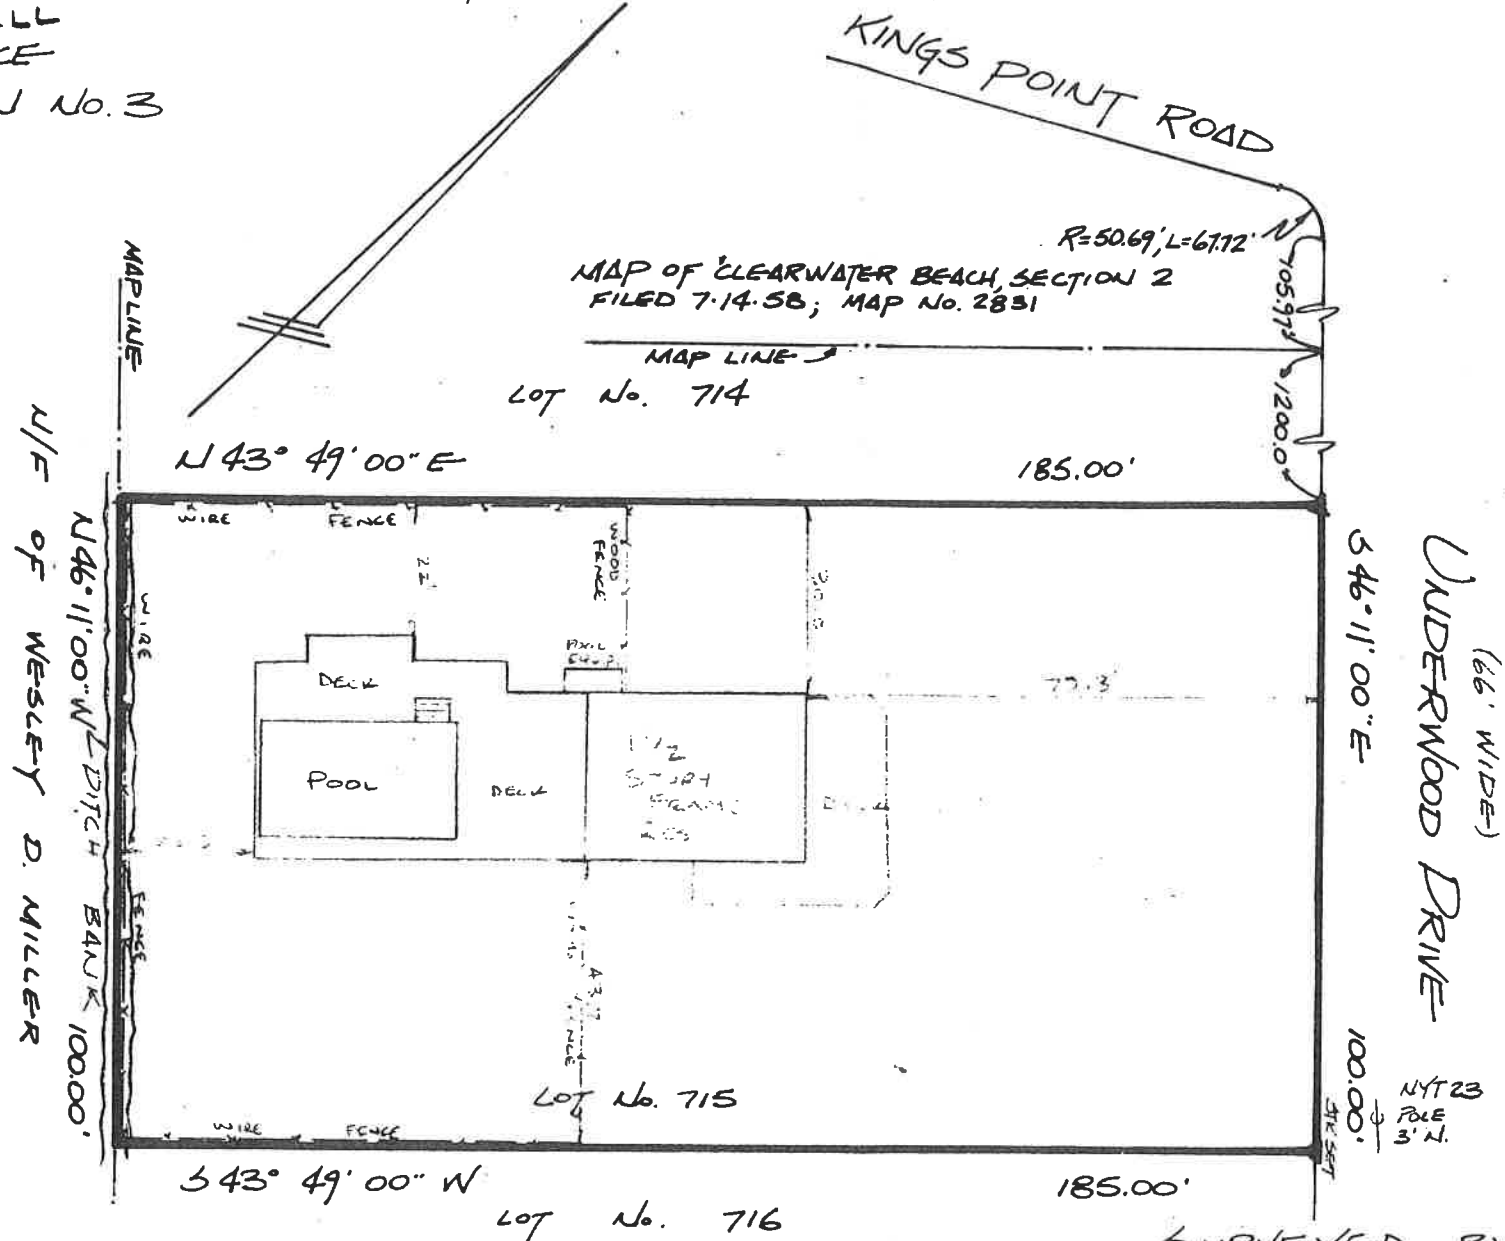

Unauthorized alteration or addition to this survey is a violation of section 7209 of the New York State Education Law.

Copies of this survey map not bearing the Land Surveyor's label or embossed seal shall not be considered to be a valid true

statements or certifications indicated hereon shall run only to the person for whom the survey is prepared, and on his behalf to the title company, governmental agency and lending institution hereon, and to the assignees of the lending institution. Statements or certifications are not transferable to additional parties or subsequent owners.



SURVEYED BY:
 FRANK J. BARYLSKI
 BRIDGEHAMPTON, N.Y.
 SAYVILLE, N.Y.
 N.Y.S. LIC. No. 44224
 MAY 04, 1982

UPDATE SURVEY & POOL S.O. 5-11-96