

MAP OF PROPERTY
LOT 6
EAST END ESTATES
dated: June 19, 1978 -- Map No. 66
SITUATE
MONTAUK


Town Of East Hampton, Suffolk Co., N.Y.
Scale: 1"=30'
Area: 30,323 S.F. or 0.696 Acres

Certified To:
Joseph Tranchina

Revised:	July 18, 2012	--Well Revised
Revised: <td>July 6, 2012 <td>--Well</td> </td>	July 6, 2012 <td>--Well</td>	--Well
Revised: <td>June 29, 2012 <td>--Laterals</td> </td>	June 29, 2012 <td>--Laterals</td>	--Laterals
Revised: <td>June 18, 2012 <td>--Revo.</td> </td>	June 18, 2012 <td>--Revo.</td>	--Revo.
Revised: <td>April 27, 2012 <td>--Fing.</td> </td>	April 27, 2012 <td>--Fing.</td>	--Fing.
Revised: <td>Sept. 9, 2011 <td>--Slk. Pool Envelope, Loc.</td> </td>	Sept. 9, 2011 <td>--Slk. Pool Envelope, Loc.</td>	--Slk. Pool Envelope, Loc.
Revised: <td>Aug. 23, 2011 <td>--Clearing & Stake Well</td> </td>	Aug. 23, 2011 <td>--Clearing & Stake Well</td>	--Clearing & Stake Well
Revised: <td>May 12, 2011 <td>--Stake House & Clearing</td> </td>	May 12, 2011 <td>--Stake House & Clearing</td>	--Stake House & Clearing
Surveyed: <td>April 28, 2011 <td></td> </td>	April 28, 2011 <td></td>	

GEORGE WALBRIDGE SURVEYORS, P.C.
Land Surveyors & Land Planners
300 Pentigo Place - Suite 116
East Hampton, Long Island, N.Y. 11937
Phone: (631) 324-0412 Fax: (631) 324-9849
E-mail: chsuvrvtor@aol.com

c:\land projects\tranchina\dwg\survey_7-18-12

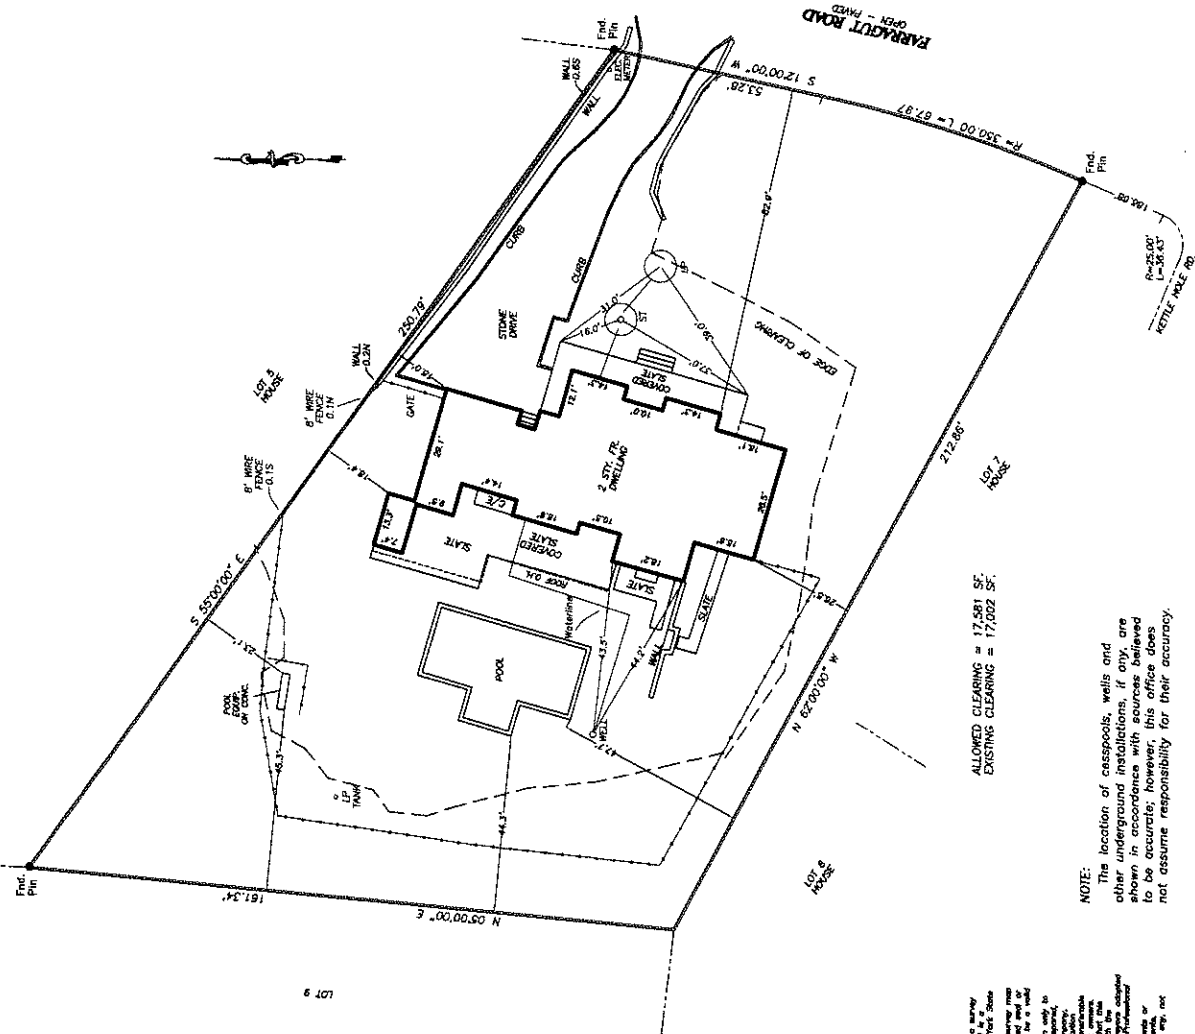

ALLOWED CLEARING = 17,581 SF.
EXISTING CLEARING = 17,002 SF.

NOTE: The location of cesspools, wells and other underground installations, if any, are shown in accordance with sources believed to be accurate; however, this office does not assume responsibility for their accuracy.

chld's term - 5/24/12

[illegible]