
16'_{X50'} VGROUND POOL

SLATE

LOT 3

194.36

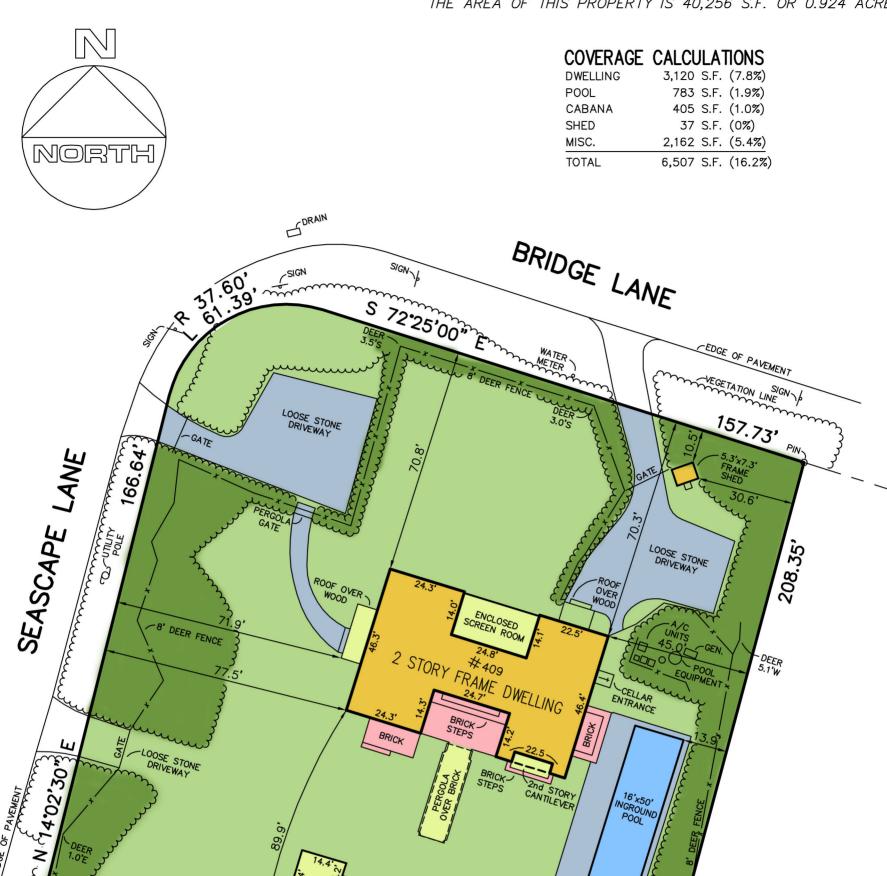

CERTIFIED TO: Gerry Teplitsky and Joey Issacs

REBAR 0.3'S 0.1'E

GUARANTEES INDICATED SHALL RUN ONLY TO THE PERSON FOR WHOM THE SURVEY IS PREPARED AND/OR AGENCY, AND ARE NOT TRANSFERABLE.

LOT 6

-VEGETATION LINE

S.C.T.M. NO. 908

N 71°51'40" W

SURVEY OF: LOT No. 3

MAP OF SEASCAPE, SECTION 1

FILED OCT. 15, 1964 - AS No. 4182

SITUATED IN: INCORPORATED SAGAPONACK TOWN OF: SOUTHAMPTON

SUFFOLK COUNTY, NEW YORK

DATE: *9/4/2015* JOB NO. *G15-1553* SCALE: 1" = 30'

GARY BENZ, L.S.

Surveying and Land Planning 24 Shorehaven Blvd. Ronkonkoma, N.Y. 11779

LOTA

LOT >

GaryBenzLS@Yahoo.com / (631) 648-9348

THE EXISTENCE OF RIGHTS OF WAY AND/OR EASEMENTS OF RECORD IF ANY, NOT SHOWN ARE NOT GUARANTEED.

UNAUTHORIZED ALTERATION OR ADDITION TO THIS SURVEY IS A VIOLATION OF SECTION 7209 OF THE NEW YORK STATE EDUCATION LAW.