


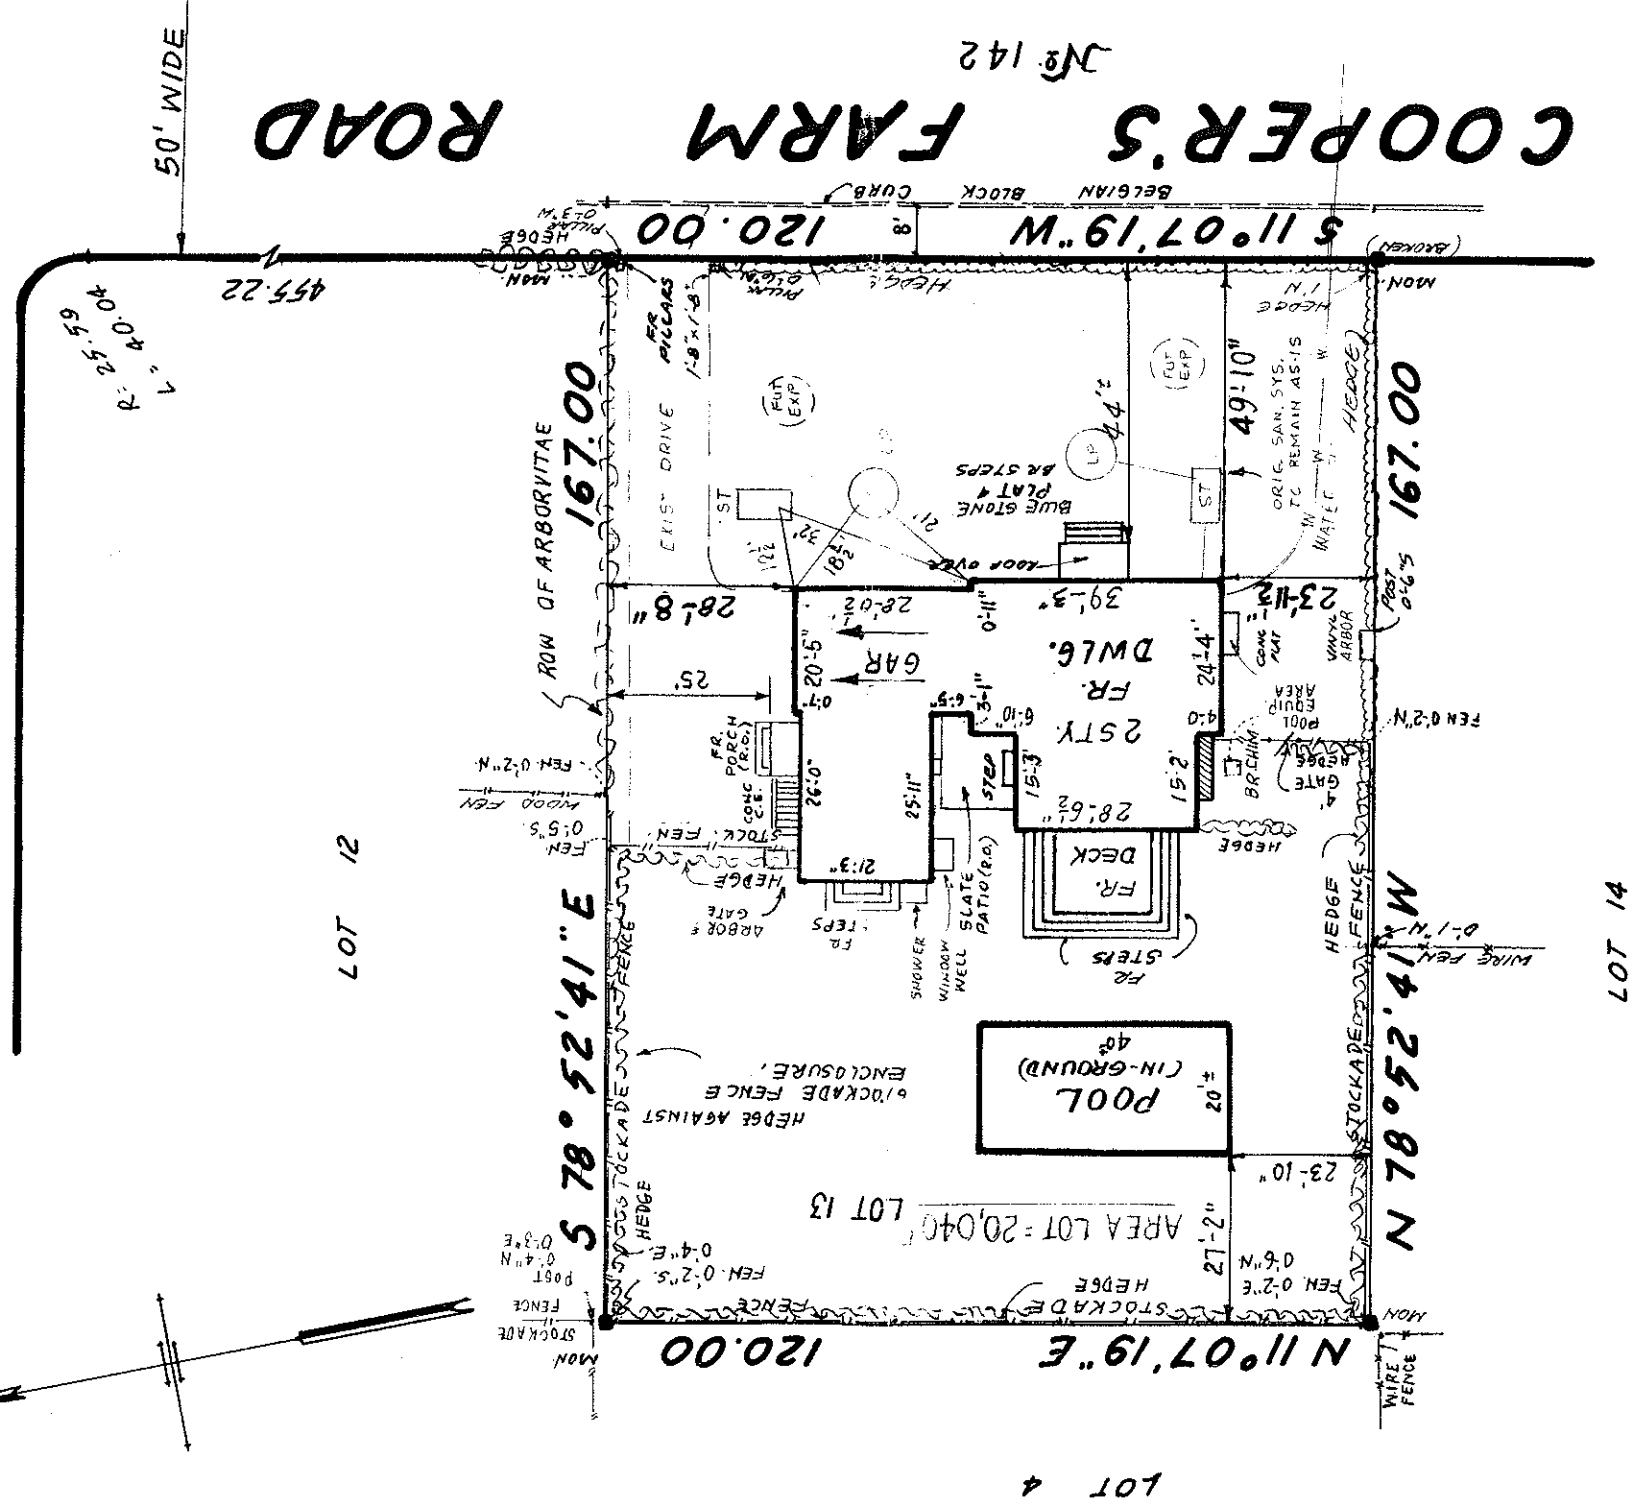

SURVEY OF PROPERTY
Situated in the
INCORPORATED VILLAGE
OF SOUTHAMPTON
SUFFOLK COUNTY
NEW YORK
SCALE: 1" = 30'

Ernest J. Jang
Professional Land Surveyor
120 MEDFORD AVE.
PATCHOGUE, N.Y.
Phone 475-3192

(FINAL-SET 4 MON'S.)
UP-DATED
NOV. 4, 2005

DATES SURVEYED: SEPTEMBER 29, 1995; MARCH 5, 1996 U.C. SURVEY; OCT. 11, 1996; U.C. SURVEY; NOV. 4
 (FINAL SURVEY) UPDATE 4/2008

- THIS SURVEY WAS PREPARED IN ACCORDANCE WITH THE EXISTING CODE OF PRACTICE FOR LAND SURVEYS ADOPTED BY THE NEW YORK STATE ASSOCIATION OF PROFESSIONAL LAND SURVEYORS.
- UNAUTHORIZED ALTERATION OR ADDITION TO THIS SURVEY IS A VIOLATION OF SECTION 7209 OF THE NEW YORK STATE EDUCATION LAW. COPIES OF THIS SURVEY MAP NOT BEARING THE LAND SURVEYOR'S INKED SEAL OR EMBOSSED SEAL SHALL NOT BE CONSIDERED TO BE A VALID TRUE COPY. CERTIFICATIONS INDICATED HEREON SHALL RUN ONLY TO THE PERSON FOR WHOM THE SURVEY IS PREPARED AND ON HIS BEHALF TO THE TITLE COMPANY, GOVERNMENTAL AGENCY AND LENDING INSTITUTION LISTED HEREON, AND TO THE ASSIGNEES OF THE LENDING INSTITUTIONS. CERTIFICATIONS ARE NOT TRANSFERABLE TO ADDITIONAL INSTITUTIONS OR SUBSEQUENT OWNERS.
- THE OFFSETS OR DIMENSIONS SHOWN FROM THE STRUCTURES TO THE PROPERTY LINES ARE FOR A SPECIFIC PURPOSE AND USE AND THEREFORE ARE NOT INTENDED TO GUIDE THE ERECTION OF FENCES, RETAINING WALLS, POOLS, PATIOS, PLANTING AREAS, ADDITION TO BUILDINGS AND ANY OTHER CONSTRUCTION.
- THE EXISTENCE OF RIGHT OF WAYS AND OF EASEMENTS OF RECORD, IF ANY, NOT SHOWN ARE NOT GUARANTEED