


25,049 sq. ft.
R-12.5
ZONE

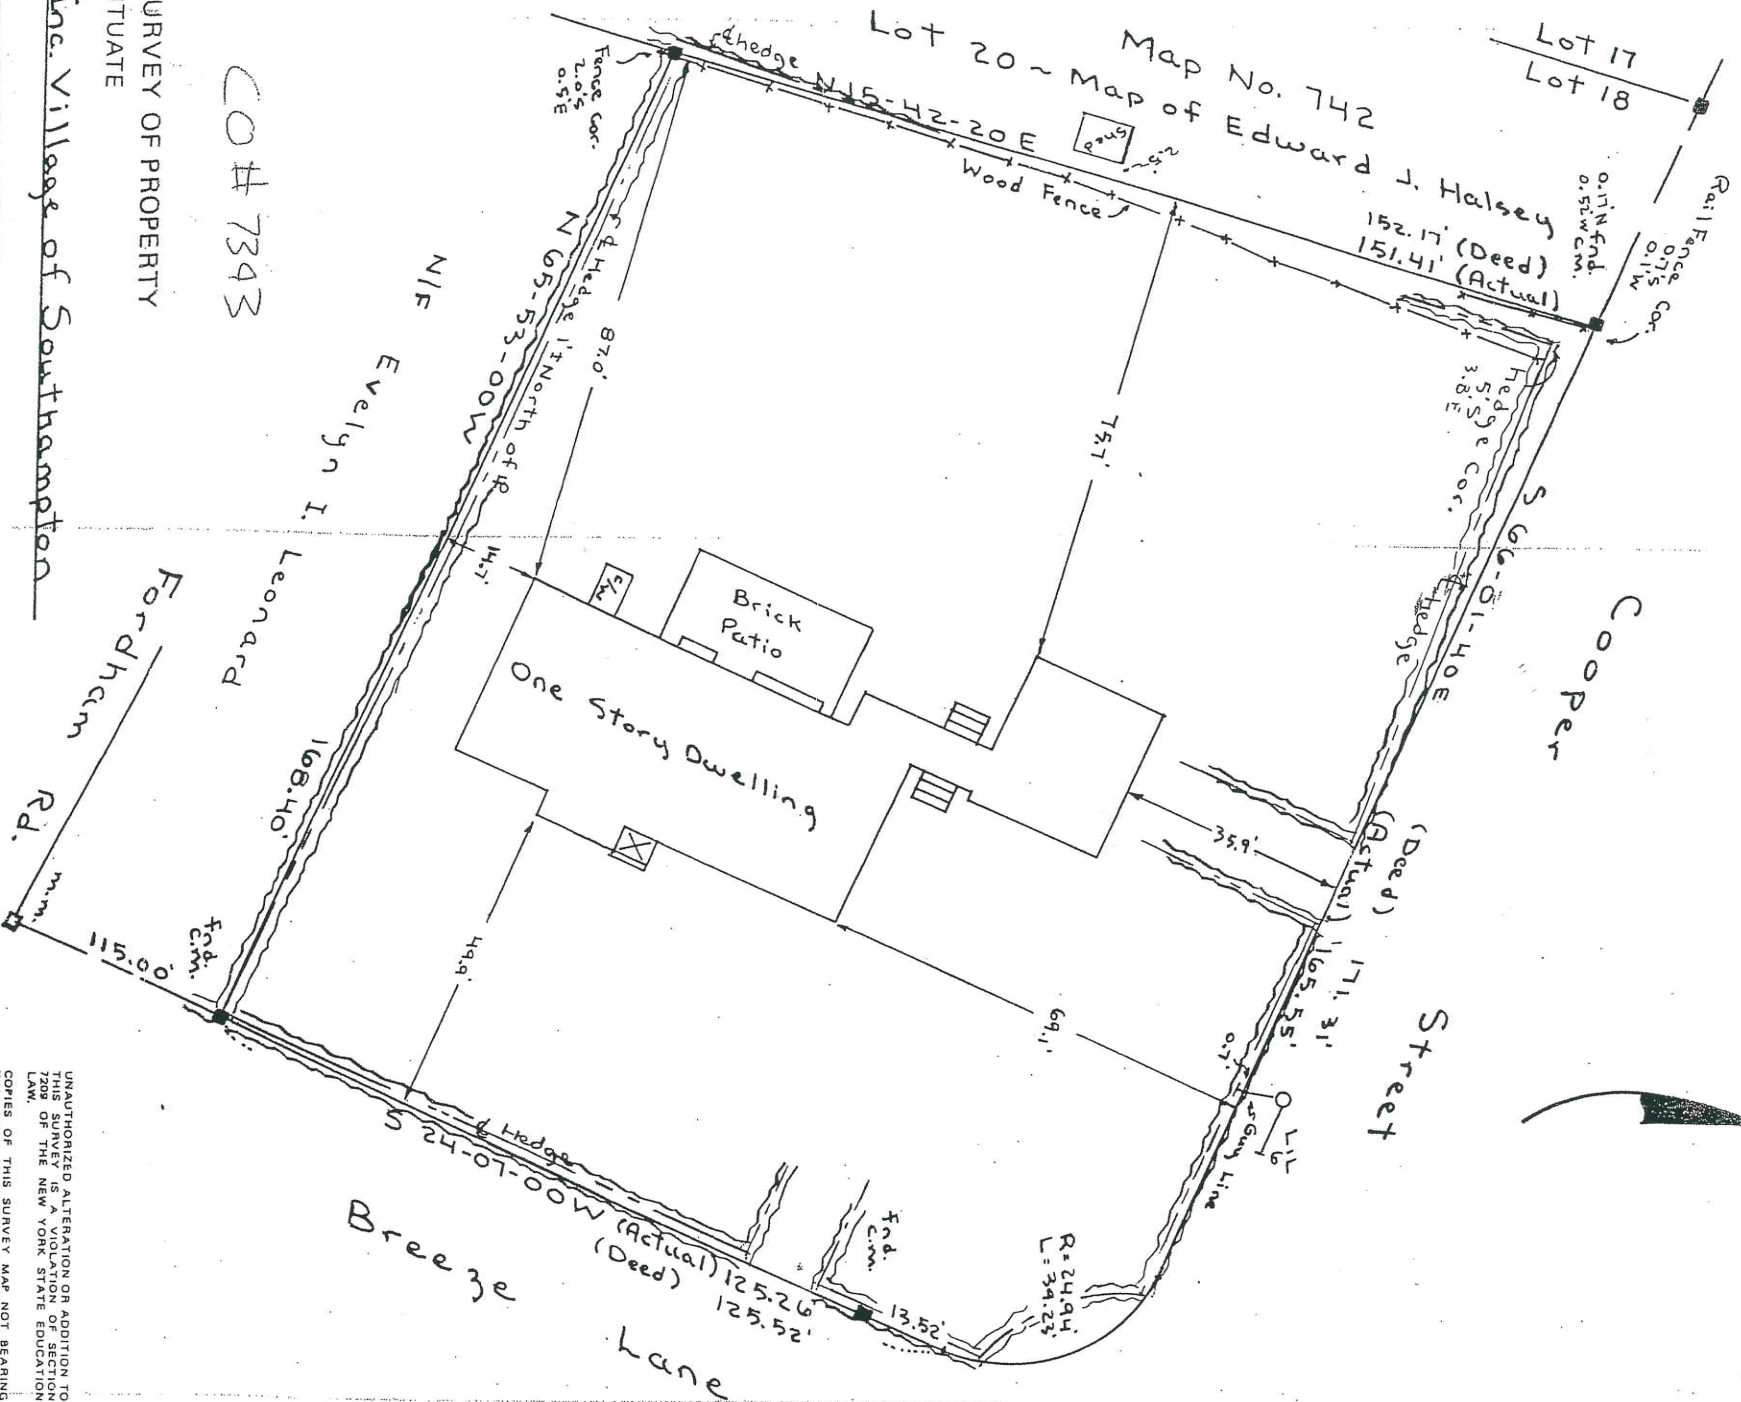

SURVEY OF PROPERTY
SITUATE

UO # 7343

Inc. Village of Southampton

TOWN OF SOUTHAMPTON
SUFFOLK COUNTY, NEW YORK

CERTIFIED TO:

Paul Texts, Trustee / Exchange

Revised Survey 11-07-97
Revised Survey #
Proposed Addition 9-15-93
JACOB M. BUCHHEIT
LICENSE NO. 47400
Jacob M. Buchheit

WILLIAM G. LOWE
LICENSE NO. 49476

**DOLLIVER ASSOCIATES
LAND SURVEYORS
HAMPTON BAYS, N. Y.**

UNAUTHORIZED ALTERATION OR ADDITION TO THIS SURVEY IS A VIOLATION OF SECTION 87(2)(b) OF THE NEW YORK STATE EDUCATION LAW.

COPIES OF THIS SURVEY MAY NOT BEARINGED BY SURVEYORS. ANY SEAL OR EMBOSSING OF SURVEYORS' NAMES IS CONSIDERED TO BE A VALID TRUE COPY.

GUARANTEES INDICATED HEREON SHALL APPLY ONLY TO THE PERSON TO WHOM THE SURVEY IS PREPARED, AND ON HIS BEHALF TO THE TITLE COMPANY, GOVERNMENTAL AGENCY AND TO THE SIGNED PARTIES. IF THE SURVEY IS TO BE THE BASIS FOR A LIMITED WARRANTY AND TION, GUARANTEES ARE NOT TRANSFERABLE TO ADDITIONAL INSTITUTIONS OR SUBSEQUENT OWNERS.

R.O.W. EASEMENTS, AND UNDERGROUND UTILITIES, ARE NOT SHOWN ON THIS SURVEY UNLESS THEY ARE NOTED AND NOT SHOWN ON THIS SURVEY.

PREPARED _____
SCALE 1" = 30'

SURVEYED Feb. 27, 1985

■ DENOTES MONUMENTS

Δ DENOTES STAKES

BK 134 PG 8081

DYNE POST N44072