



SURVEY OF PROPERTY
SITUATED AT
THE INCORPORATED VILLAGE OF
EAST HAMPTON
TOWN OF EAST HAMPTON
SUFFOLK COUNTY, NEW YORK
S.C. TAX No. 301-12-03-07

SCALE 1"=20'
MARCH 8, 1999
OCTOBER 2, 2000 FINAL SURVEY

AREA = 44,405.79 sq. ft.
1.019 ac.

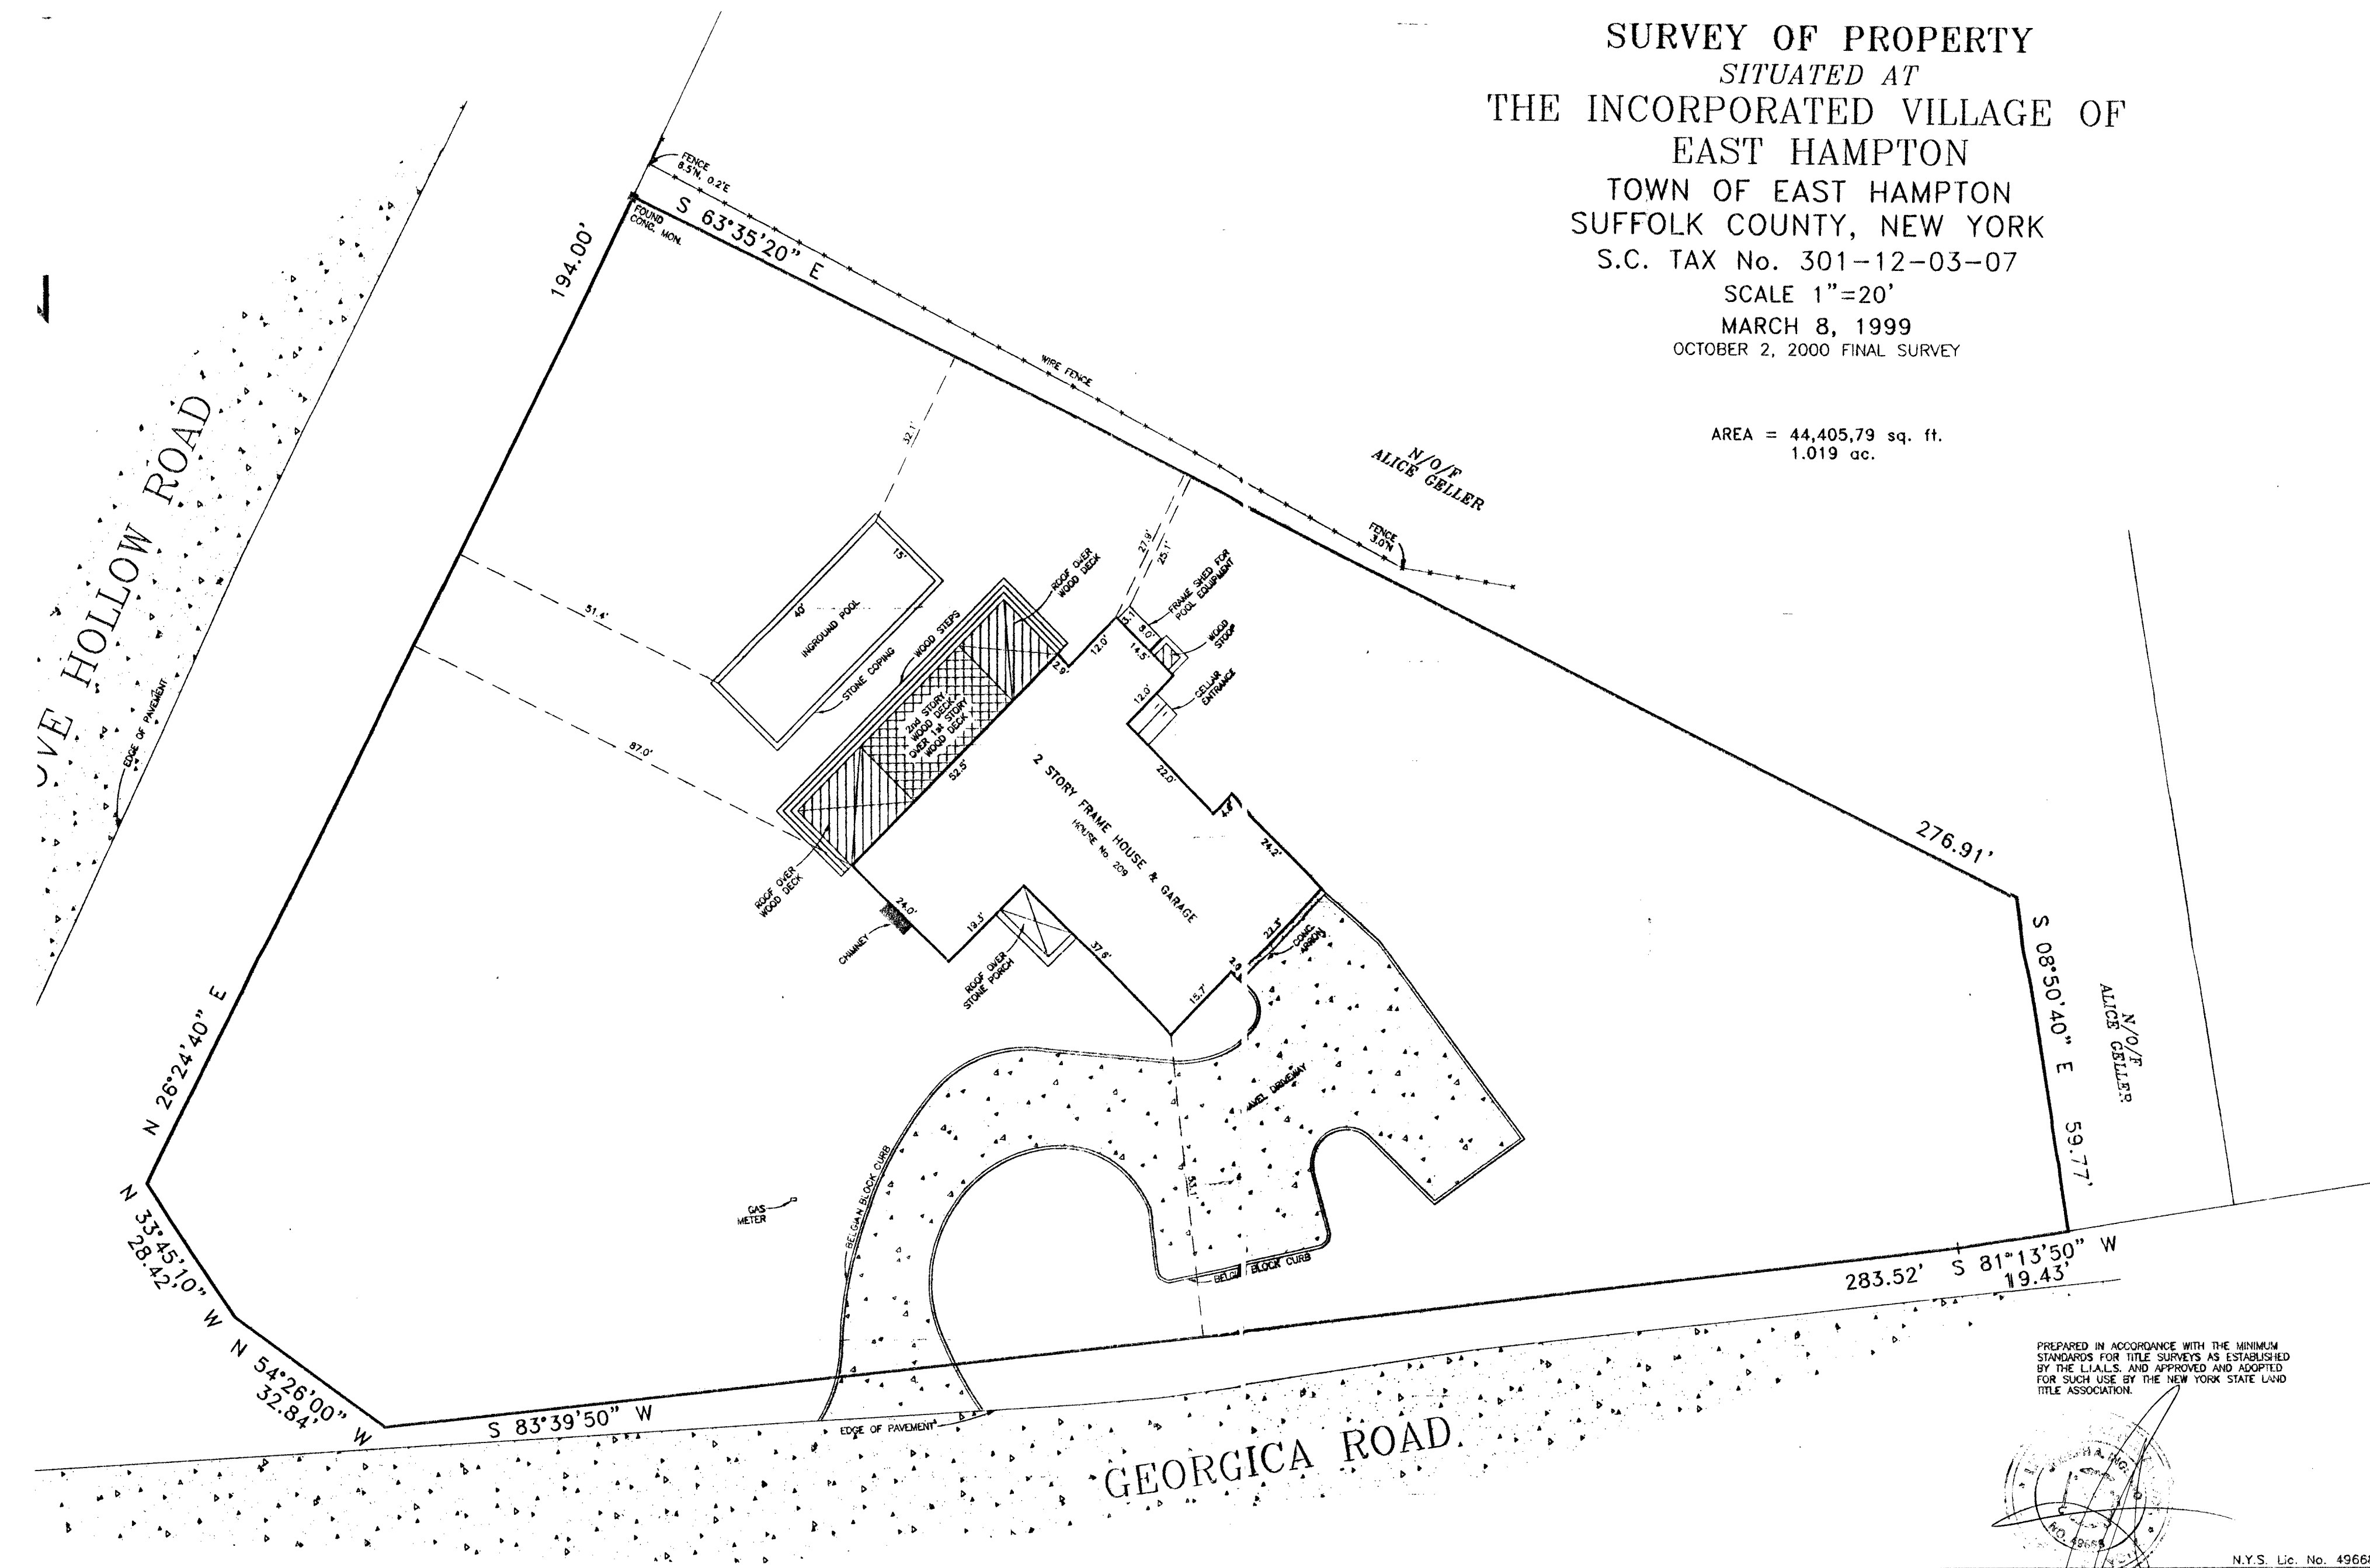

PREPARED IN ACCORDANCE WITH THE MINIMUM
STANDARDS FOR TITLE SURVEYS AS ESTABLISHED
BY THE L.L.A.S. AND APPROVED AND ADOPTED
FOR SUCH USE BY THE NEW YORK STATE LAND
TITLE ASSOCIATION.

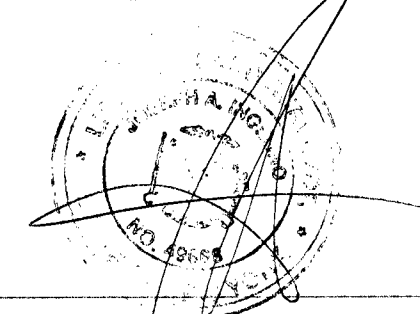

N.Y.S. Lic. No. 49668

CERTIFIED TO:
TICOR TITLE GUARANTEE COMPANY
LAWRENCE RICH
SEYMOUR LEVY

UNAUTHORIZED ALTERATION OR ADDITION
TO THIS SURVEY IS A VIOLATION OF
SECTION 7209 OF THE NEW YORK STATE
EDUCATION LAW.

COPIES OF THIS SURVEY MAP NOT BEARING
THE LAND SURVEYOR'S INKED SEAL OR
EMBOSSED SEAL SHALL NOT BE CONSIDERED
TO BE A VALID TRUE COPY.

CERTIFICATIONS INDICATED HEREON SHALL RUN
ONLY TO THE PERSON FOR WHOM THE SURVEY
IS PREPARED, AND ON HIS BEHALF TO THE
TITLE COMPANY, GOVERNMENTAL AGENCY AND
LENDING INSTITUTION LISTED HEREON, AND
TO THE ASSIGNEES OF THE LENDING INSTI-
TUTION. CERTIFICATIONS ARE NOT TRANSFERABLE.

THE EXISTENCE OF RIGHTS OF WAY
AND/OR EASEMENTS OF RECORD, IF
ANY, NOT SHOWN ARE NOT GUARANTEED.

Joseph A. Ingegno
Land Surveyor

Title Surveys - Subdivisions - Site Plans - Construction Layout

PHONE (631) 727-2090

Fax (631) 727-1727

OFFICES LOCATED AT
1380 ROANOKE AVENUE
RIVERHEAD, New York 11901

MAILING ADDRESS
P.O. Box 1931
Riverhead, New York 11901-0965