


SECHS Ref #10-04 0144

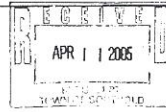

**SURVEY OF PROPERTY
AT PECONIC
TOWN OF SOUTHOLD
SUFFOLK COUNTY, N.Y.**

1000-88-04-110

SCALE: 1"=40'


AUGUST 9, 2004

Nov 30, 2004 (revisions)

1st 1/2 built cabana

SUFFOLK COUNTY DEPARTMENT OF HEALTH SERVICES
APPROVAL OF CONSTRUCTED WORKS FOR
A SINGLE FAMILY RESIDENCE
Date JAN 03 2005 H.S. Ref. No. RD-04-0144
The sewage disposal and water supply facilities at this location have been inspected and/or certified by this Department or other agencies and found to be satisfactory FOR A MAXIMUM OF 4 BEDROOMS.
Walter J. Hilbert, P.E., Chief
Office of Wastewater Management

RECEIVED
SUFFOLK COUNTY
JAN 27 AM 9:20

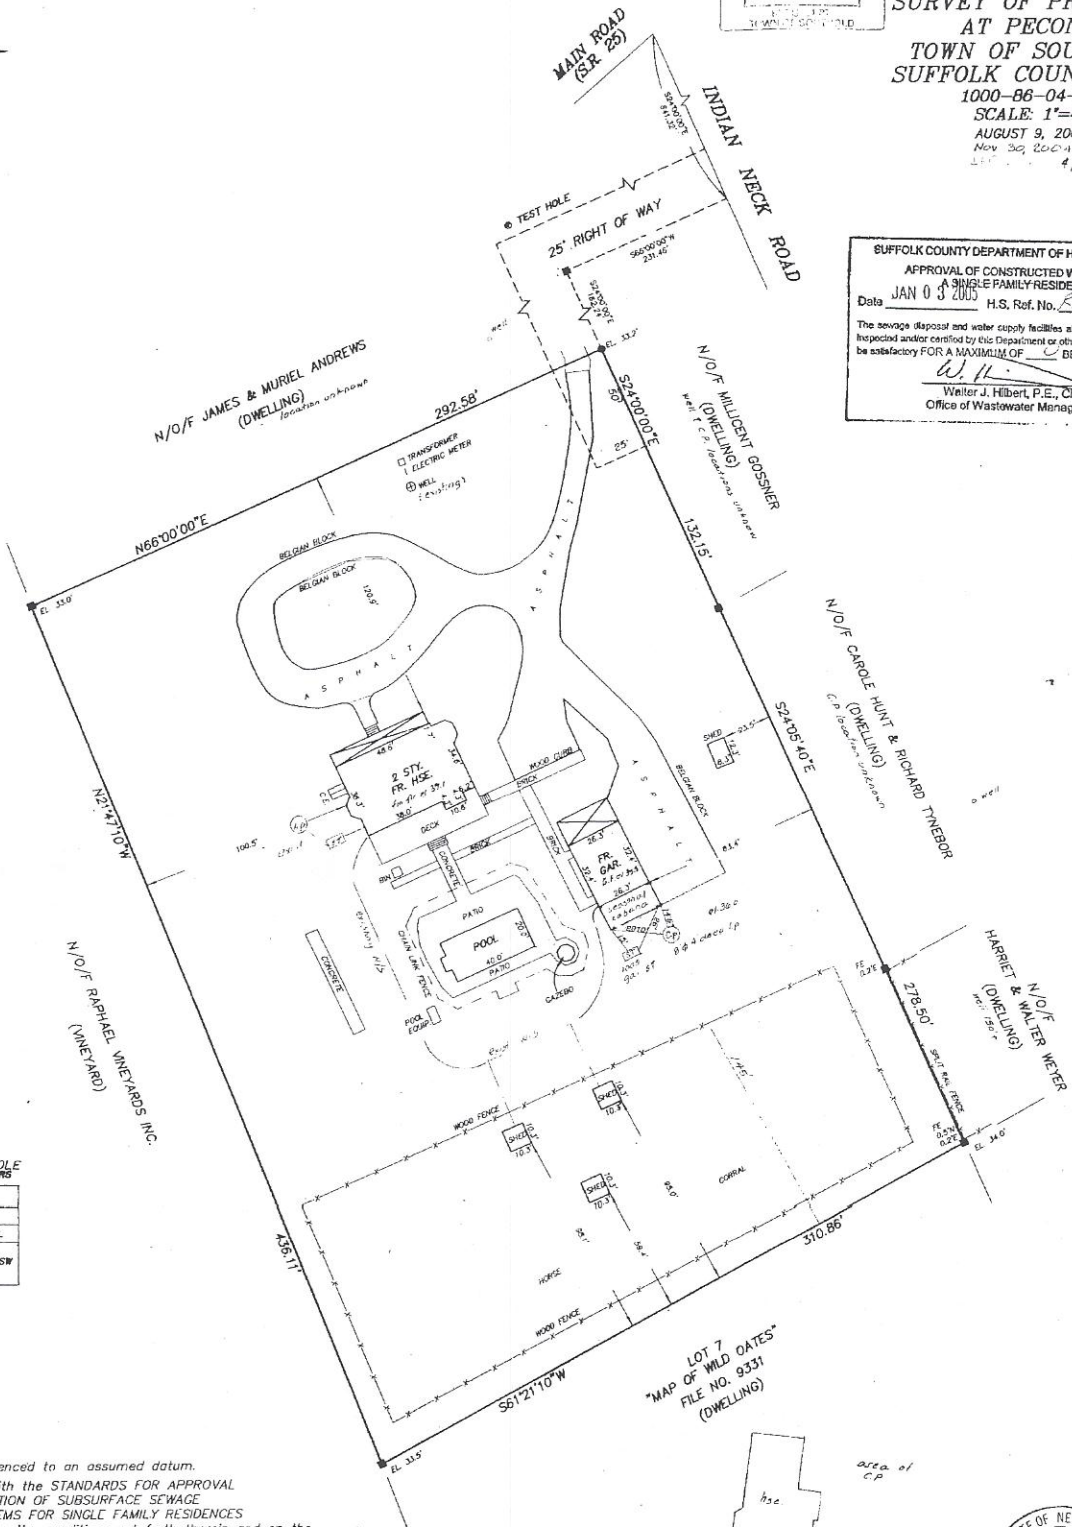

TEST HOLE
BY OTHERS

0'	TOPSOIL
1 1/2'	CLAY
2 1/2'	LOAM CL
3 1/2'	SAND SW
17'	

Elevations referenced to an assumed datum.
I am familiar with the STANDARDS FOR APPROVAL
AND CONSTRUCTION OF SUBSURFACE SEWAGE
DISPOSAL SYSTEMS FOR SINGLE FAMILY RESIDENCES
and will abide by the conditions set forth therein and on the
permit to construct.

The location of wells and cesspools shown hereon are
from field observations and or from data obtained from others.

ANY ALTERATION OR ADDITION TO THIS SURVEY IS A VIOLATION
OF SECTION 7209 OF THE NEW YORK STATE EDUCATION LAW.
EXCEPT AS PER SECTION 7209-SUBDIVISION 2. ALL CERTIFICATIONS
HEREON ARE VALID FOR THIS MAP AND COPIES THEREOF ONLY IF
SAID MAP OR COPIES BEAR THE IMPRESSED SEAL OF THE SURVEYOR
WHOSE SIGNATURE APPEARS HEREON.

■=MONUMENT
●=PIPE
AREA=2.9233 ACRES

STATE OF NEW YORK
JOHN T. MELODY
PECONIC SURVEYORS, P.C.
(631) 765-5122 (631) 765-1797
P.O. BOX 9000
1230 TRAVELER STREET
SOUTHOLD, N.Y. 11971
01-119