

DRAWN BY: RRM	DATE: 11-04-94
CHECKED BY: JM	BRANDS NO.: 701-94
JOB NO.: 701-94	SHEET OF



UNAUTHORIZED ALTERATION OR ADDITION TO THIS SURVEY IS A VIOLATION OF SECTION 7209 OF THE NEW YORK STATE EDUCATION LAW.

COPIES OF THIS SURVEY MAP NOT BEARING THE LAND SURVEYOR'S INKED SEAL OR EMBOSSED SEAL SHALL NOT BE CONSIDERED TO BE A VALID TRUE COPY.

THE EXISTENCE OF RIGHT OF WAYS AND OR/EASEMENTS OF RECORD IF ANY, NOT SHOWN ARE NOT GUARANTEED.

THE WATER SUPPLY, WELLS AND CESSPOOLS SHOWN HEREON ARE FROM FIELD OBSERVATIONS AND OR DATA OBTAINED FROM OTHERS.


GUARANTEES INDICATED HEREON SHALL RUN ONLY TO THE PERSON FOR WHOM THE SURVEY IS PREPARED, AND ON HIS BEHALF TO THE TITLE COMPANY, GOVERNMENTAL AGENCY AND LENDING INSTITUTION LISTED HEREON, AND TO THE ASSIGNEES OF THE LENDING INSTITUTION. GUARANTEES ARE NOT TRANSFERABLE.

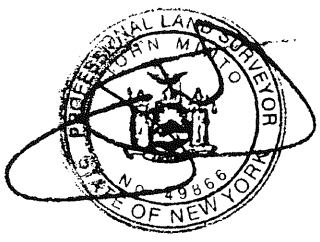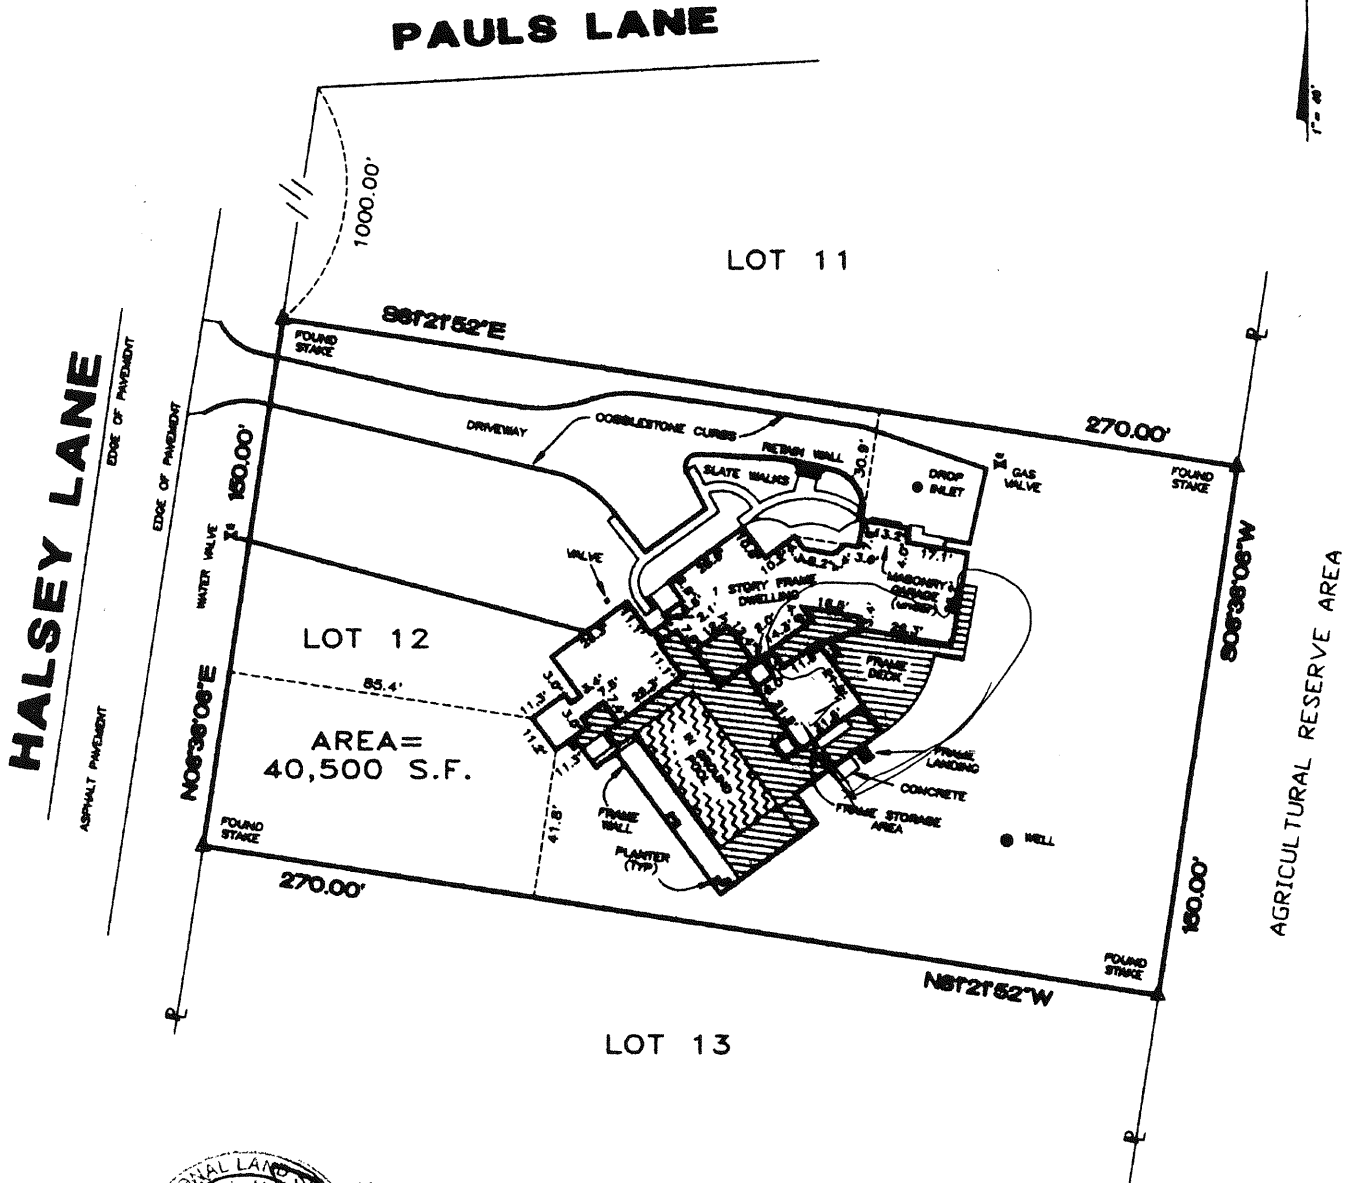


33283

**FINAL SURVEY OF LOT 12**

SUBDIVISION MAP OF BROADLANDS  
 FILED AUGUST 29, 1980 FILE NO. 6930  
 SITUATE AT  
**BRIDGEHAMPTON**  
 SUFFOLK COUNTY, NEW YORK  
**S.C.T.M. #900-105-01-1.12**  
 SCALE 1" = 40' NOV. 3, 1994  
 GRAPHIC SCALE

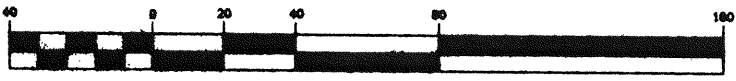

( IN FEET )  
 1 inch = 40 ft.



**LAND SURVEYING**

SUBDIVISIONS  
 TITLE & MORTGAGE SURVEYS  
 TOPOGRAPHIC SURVEYS  
 LAND PLANNERS  
 SITE PLANS  
 TEST BORINGS

**JOHN MINTO, L.S.**  
 LICENSED PROFESSIONAL LAND SURVEYOR  
 NEW YORK STATE LIC. NO. 49866

PHONE: (516) 724-4832  
 FAX: (516) 265-4283

196 ALEXANDER AVENUE NESCONSET, N.Y. 11767