

JOB NO. 3054 ~ D5277

SUFFOLK COUNTY TAX MAP


DISTRICT 0900
SECTION 034.00
BLOCK 02.00
PARCEL 044.008

AUG 6 1998

R09-97-0394

JUN 30 1998

NOTE: WELL, CESSPOOL & SEPTIC TANK LOCATIONS ARE ACCORDING TO S.C.H.D. REF. NO. R09 - 97 - 0394.

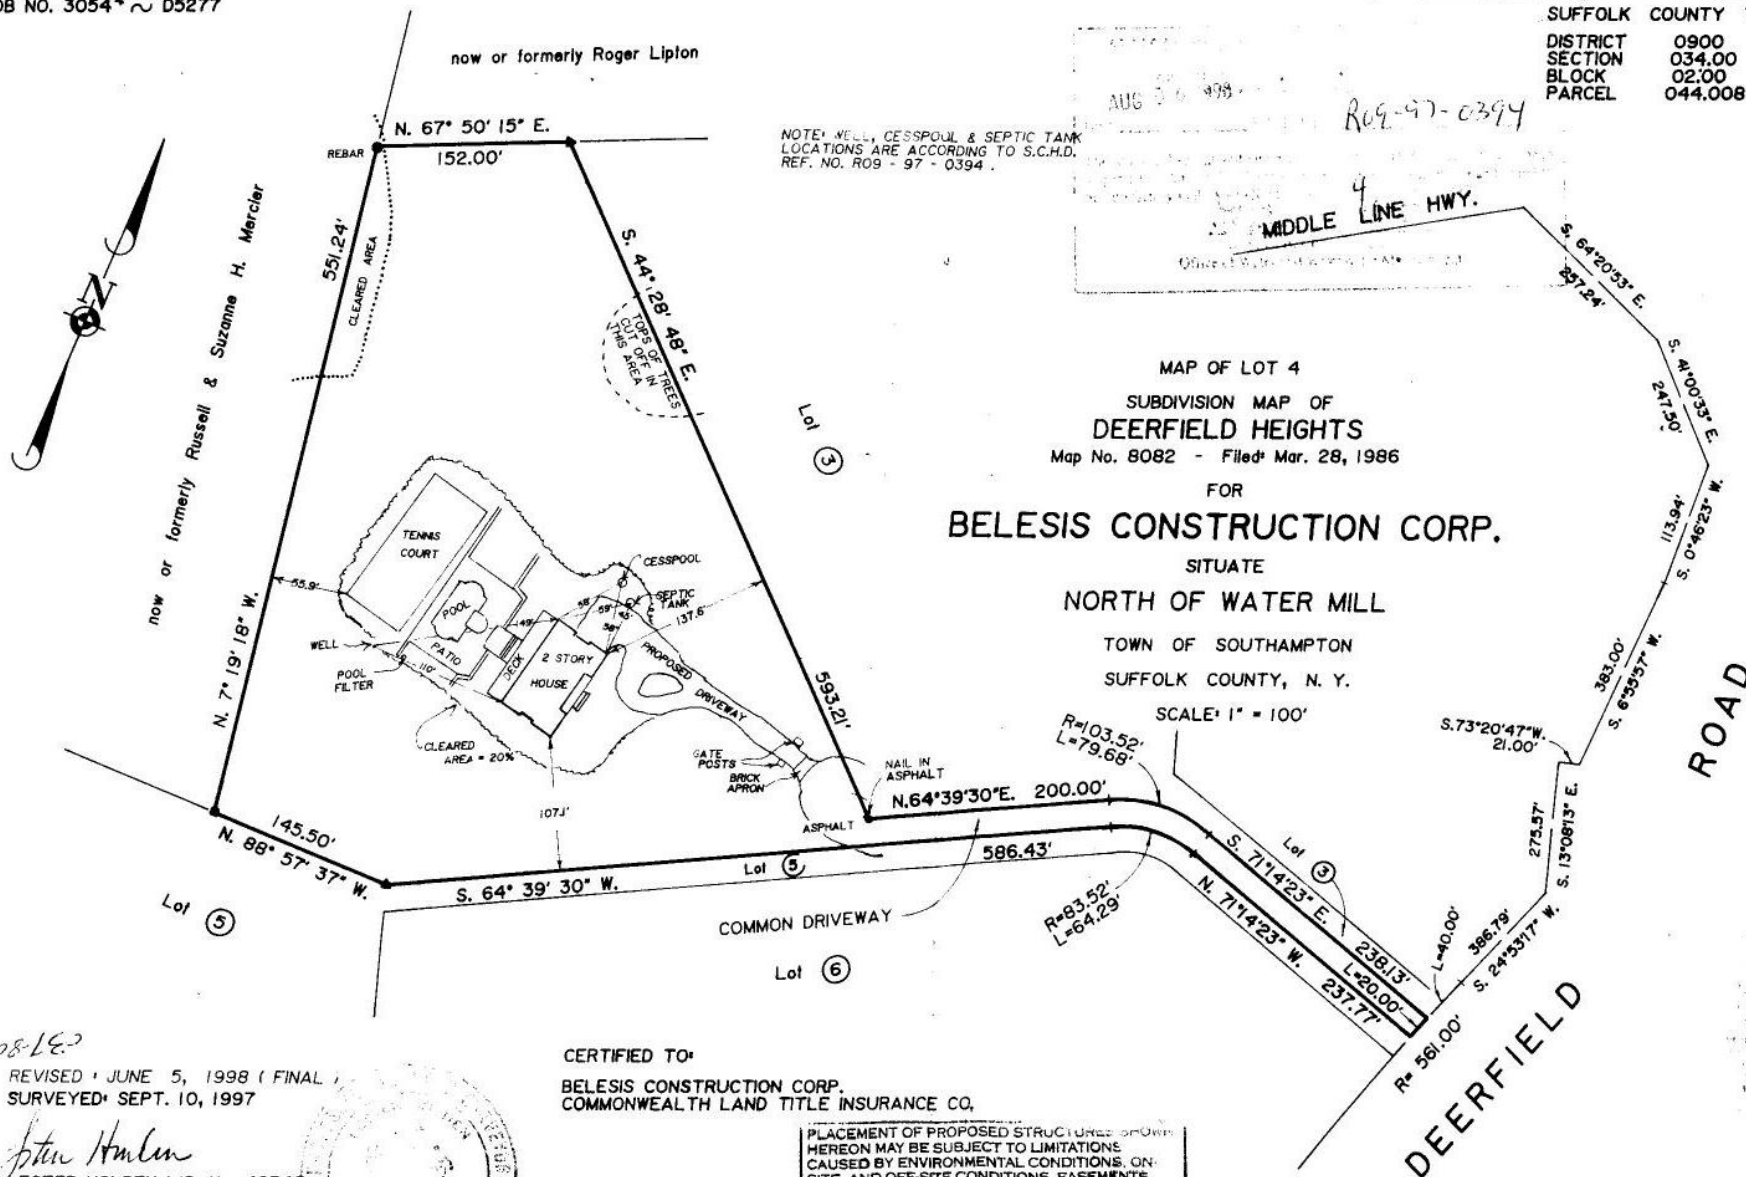

MAP OF LOT 4
SUBDIVISION MAP OF
DEERFIELD HEIGHTS
Map No. 8082 - Filed Mar. 28, 1986
FOR
BELESIS CONSTRUCTION CORP.

SITUATE
NORTH OF WATER MILL
TOWN OF SOUTHAMPTON
SUFFOLK COUNTY, N. Y.

SCALE: 1" = 100'

CERTIFIED TO:
BELESIS CONSTRUCTION CORP.
COMMONWEALTH LAND TITLE INSURANCE CO.

PLACEMENT OF PROPOSED STRUCTURES HEREON MAY BE SUBJECT TO LIMITATIONS CAUSED BY ENVIRONMENTAL CONDITIONS, ON-SITE, AND OFF-SITE CONDITIONS, EASEMENTS, COVENANTS, AND RESTRICTIONS OF RECORD AND SUBJECT TO VERIFICATION BY GOVERNMENTAL AGENCIES HAVING JURISDICTION.

Area = 208,818 sq. ft. (4.793 Acres)

NOTE:
■ INDICATES MONUMENT
▲ INDICATES STAKE

REVISED: JUNE 5, 1998 (FINAL)
SURVEYED: SEPT. 10, 1997

LESTER HOLDEN L.S. No. 49548
S.H.W. & S., LAND SURVEYORS, P.C.

SQUIRES, HOLDEN, WEISENBACHER & SMITH
LAND SURVEYORS ~ ENGINEERS
SOUTHAMPTON ~ NEW YORK