


4358 - C6486

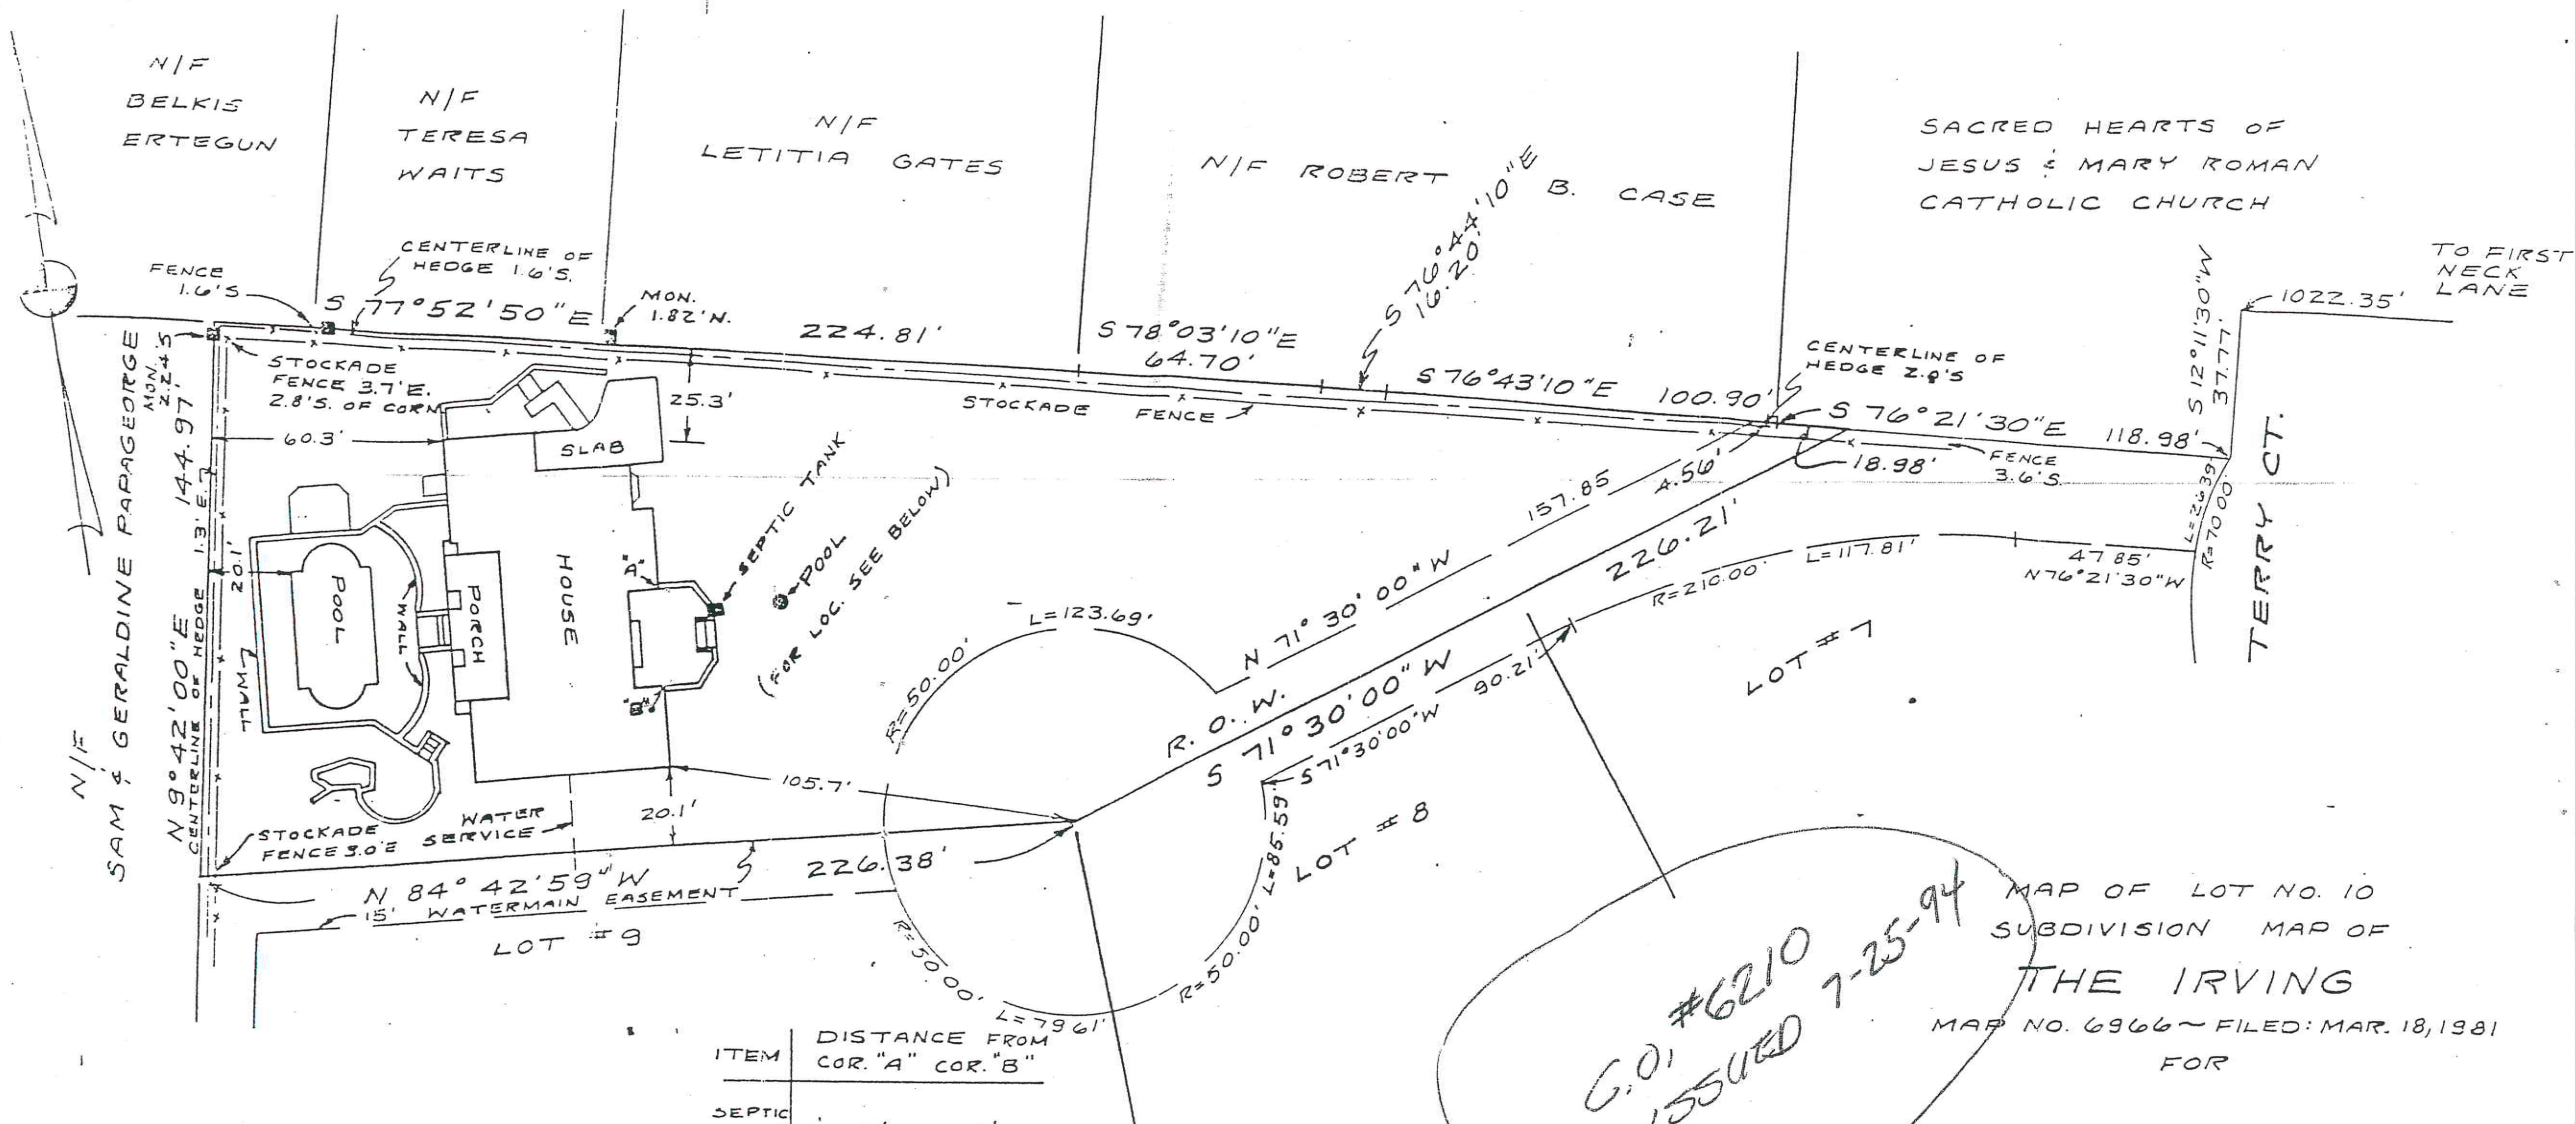

ITEM	DISTANCE FROM COR. "A" COR. "B"	
SEPTIC TANK	16'	24'
POOL	31'	37'

(LOC. PER S.C.H.D.)

BOOK	PAGE
422	141
432	8, 29, 102
436	109, 110

SUFFOLK COUNTY TAX MAP
DISTRICT: 0804
SECTION: 014.00
BLOCK: 02.00
PARCEL: 011.010

MAP OF LOT NO. 10
SUBDIVISION MAP OF
THE IRVING
MAP NO. 6966 - FILED: MAR. 18, 1981
FOR

SITUATE
THE INC. VILLAGE OF
SOUTHAMPTON
TOWN OF SOUTHAMPTON
SUFFOLK COUNTY N.Y.

SCALE 1" = 50'

SQUIRES, HOLDEN,
WEISENBACHER & SMITH

LAND SURVEYORS - ENGINEERS
SOUTHAMPTON, N.Y.