


# KELLIS POND LANE (KELLIS POND ROAD)

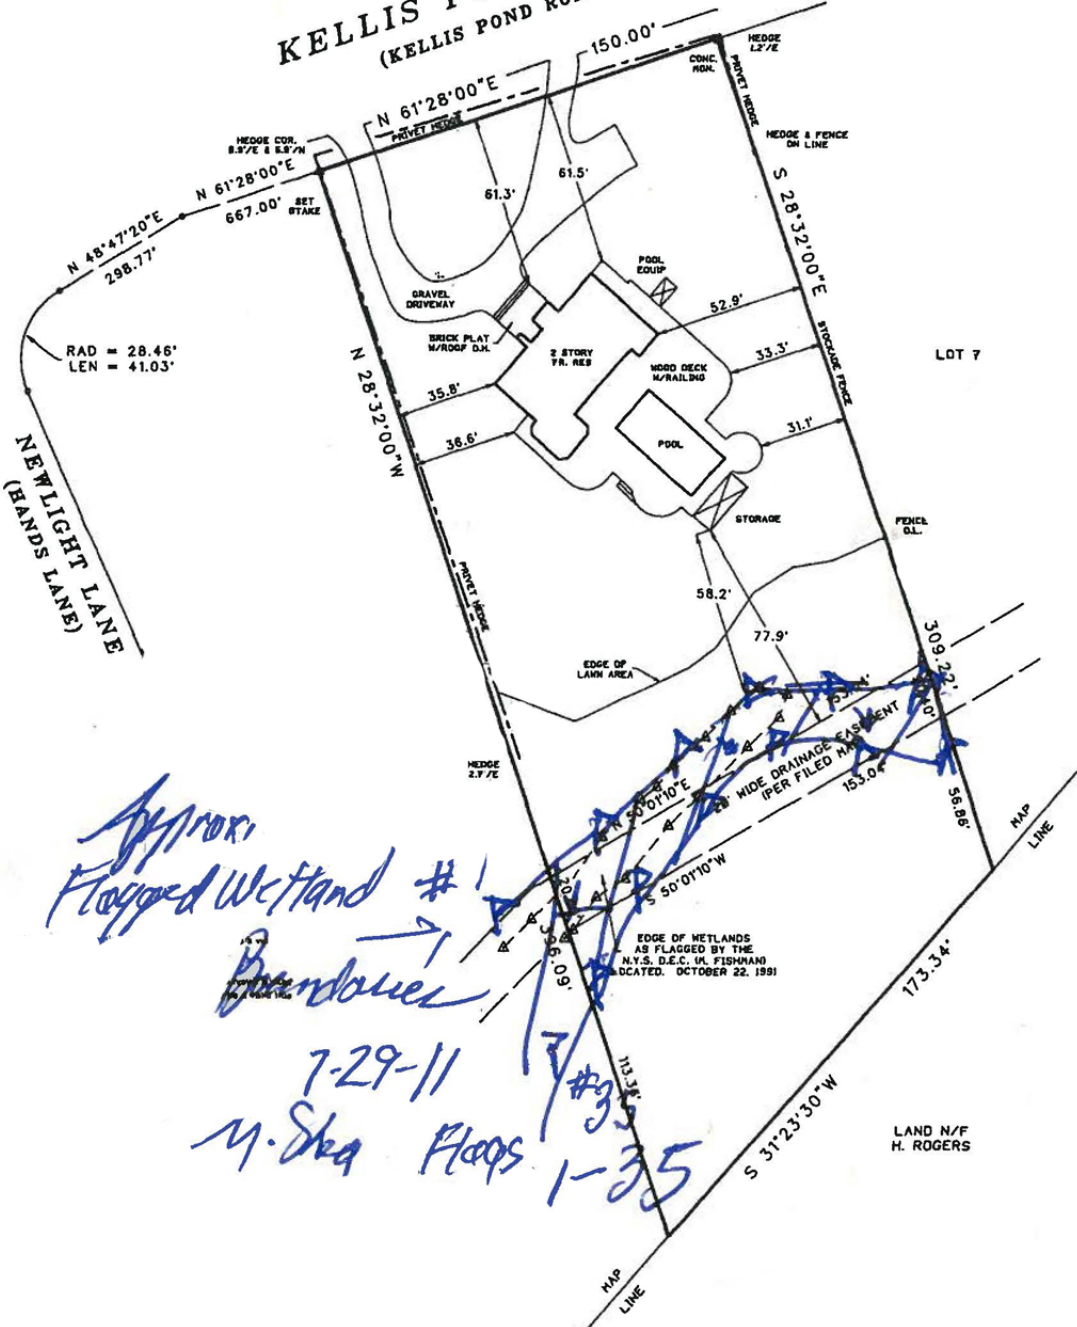

*Approx. Flagged Wetland #1*  
*Boundaries*

7-29-11  
 M. Ska Floods #35  
 1-35