


FILE NO. B-5144

TITLE NO

FROM	TO A	TO B
SEP TANK	34.2	14.6
Pool 1	36.8	27.4
Pool 2	34.3	26.1
Pool 3	21.7	21.7

SEPTIC TANK & POOL LOCATIONS

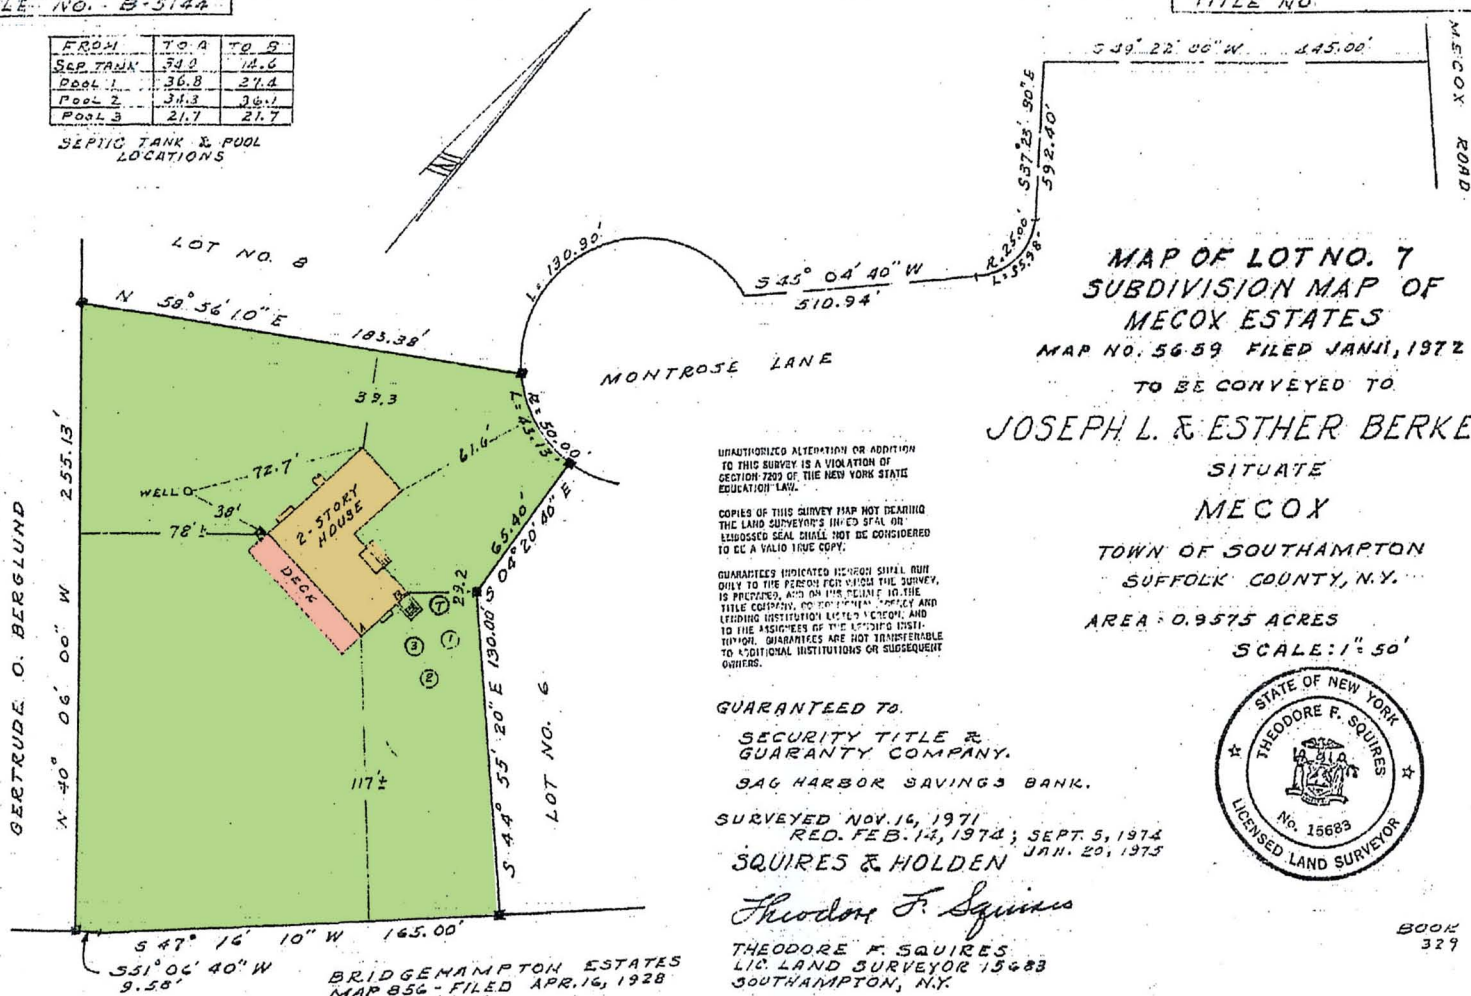

MAP OF LOT NO. 7  
 SUBDIVISION MAP OF  
 MECOX ESTATES  
 MAP NO. 56-59 FILED JANU, 1972

TO BE CONVEYED TO  
**JOSEPH L. & ESTHER BERKELEY**  
 SITUATE  
**MECOX**  
 TOWN OF SOUTHAMPTON  
 SUFFOLK COUNTY, N.Y.

AREA: 0.9575 ACRES  
 SCALE: 1" = 50'

UNAUTHORIZED ALTERATION OR ADDITION TO THIS SURVEY IS A VIOLATION OF SECTION 7202 OF THE NEW YORK STATE EDUCATION LAW.

COPIES OF THIS SURVEY MAP NOT BEARING THE LAND SURVEYOR'S INKED SEAL OR EMBOSSED SEAL SHALL NOT BE CONSIDERED TO BE A VALID TRUE COPY.

GUARANTEES INDICATED HEREON SHALL RUN ONLY TO THE PERSON FOR WHOM THE SURVEY IS PREPARED, AND ON HIS BEHALF TO THE TITLE COMPANY, FOR THE PURPOSES OF THE LEASING INSTITUTION LISTED HEREON, AND TO THE ASSIGNEES OF THE LEASING INSTITUTION. GUARANTEES ARE NOT TRANSFERABLE TO ADDITIONAL INSTITUTIONS OR SUBSEQUENT OWNERS.

GUARANTEED TO:  
 SECURITY TITLE &  
 GUARANTY COMPANY.  
 346 HARBOR SAVINGS BANK.

SURVEYED NOV. 14, 1971  
 RED. FEB. 14, 1974; SEPT. 5, 1974  
 JAN. 29, 1975  
**SQUIRES & HOLDEN**

*Theodore F. Squires*  
 THEODORE F. SQUIRES  
 LIC. LAND SURVEYOR 15683  
 SOUTHAMPTON, N.Y.



BRIDGEMAMPTON ESTATES  
 MAP 856 - FILED APR. 16, 1928