


033 B3120

900-  
388  
022  
008

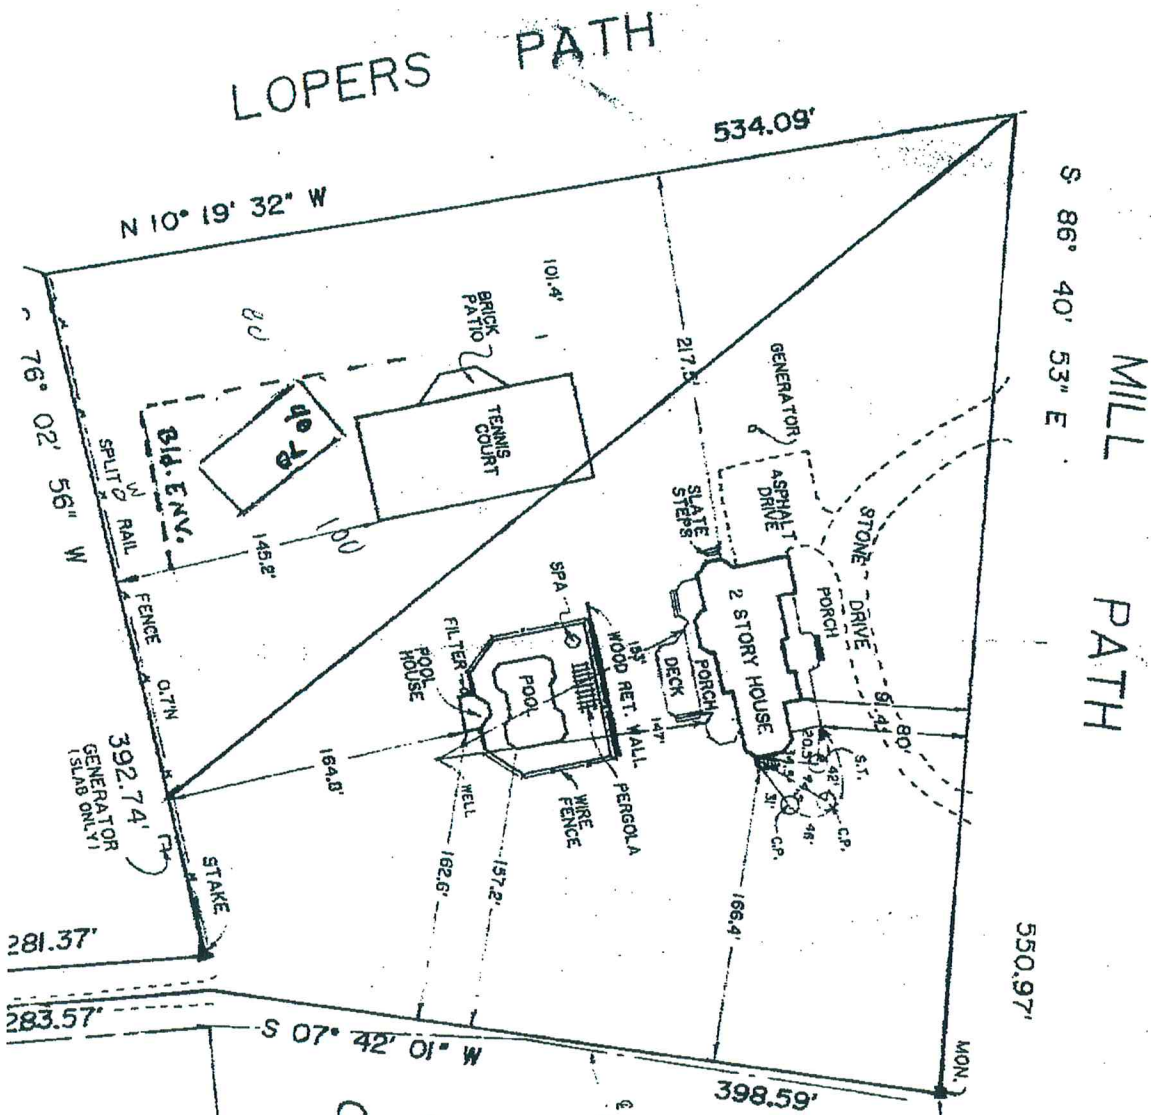

Access from Day City  
Lopers or Mill Path  
CR 80 Sat Backs

LOT 2

ROW OF PINES