


AND RAILROAD (M.T.A.)

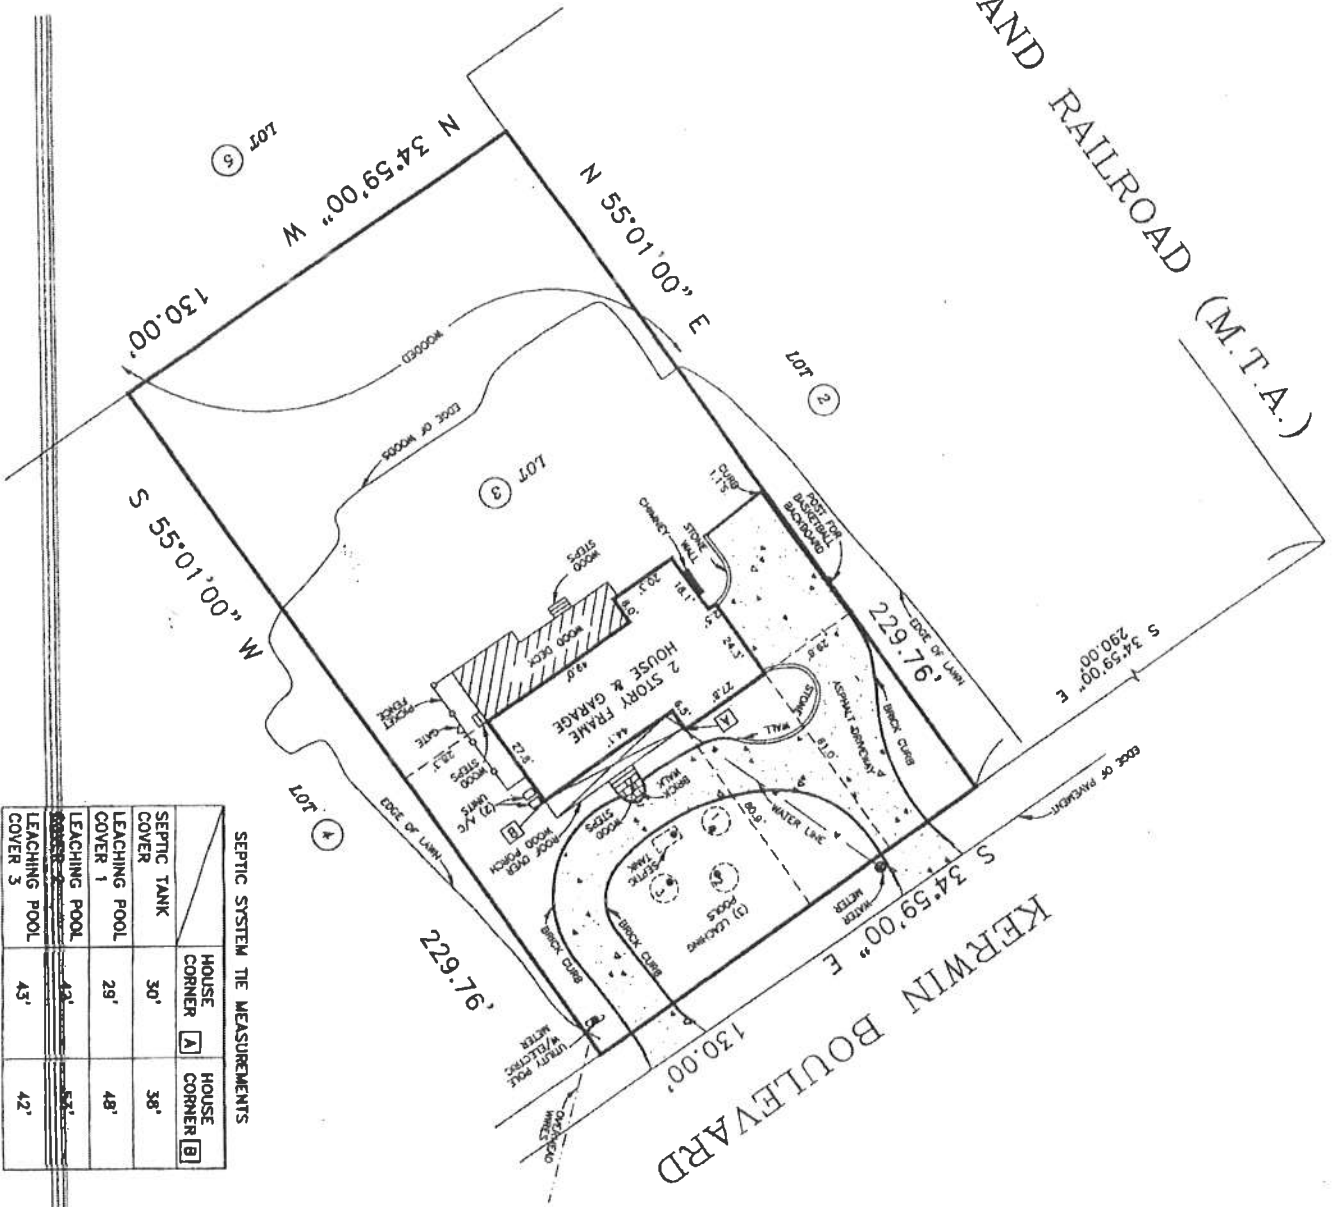

SEPTIC SYSTEM THE MEASUREMENTS		
	HOUSE CONNECTION A	HOUSE CONNECTION B
SEPTIC TANK COVER	30'	38'
LEACHING POOL COVER 1	29'	48'
LEACHING POOL COVER 2	43'	54'
LEACHING POOL COVER 3	43'	42'

SURVEY OF
LOT 3
MAP OF
CONKLING POINT ESTATE
SITUATE
ARSHAMOMAUQUE
TOWN OF SOUTHOLD
SUFFOLK COUNTY, NEW YORK
S.C. TAX No. 1000-53-04-P/O

SCALE 1"=40'
JANUARY 15, 2014
AREA = 29,869 sq. ft.
0.686 ac.

CERTIFIED TO:

[illegible]

**Nathan Taft Cor
Land Survey**



THIS SURVEY - Substation - See Power - Cor.
 ADDRESS - (33) 727-2830
 OFFICES LOCATED AT
 1585 Main Road
 P. 1
 MAIL
 P. 1